

Name

DJ Morris

Service No.

Address

14 Wandliff Rd

Location

Kind of Pipe

6" SDR 35 PVC

Size

6"

Size of Main

Repair—Renewal—New Service

Location

Date

Material

Amount

Total

Date

Amount

10/28/19


6" cleanout

6" SDR 35 PVC

DATE 10/28/19

TOWN OF LEXINGTON — BOARD OF PUBLIC WORKS
SEWER DIVISION

Sketch of Service Here

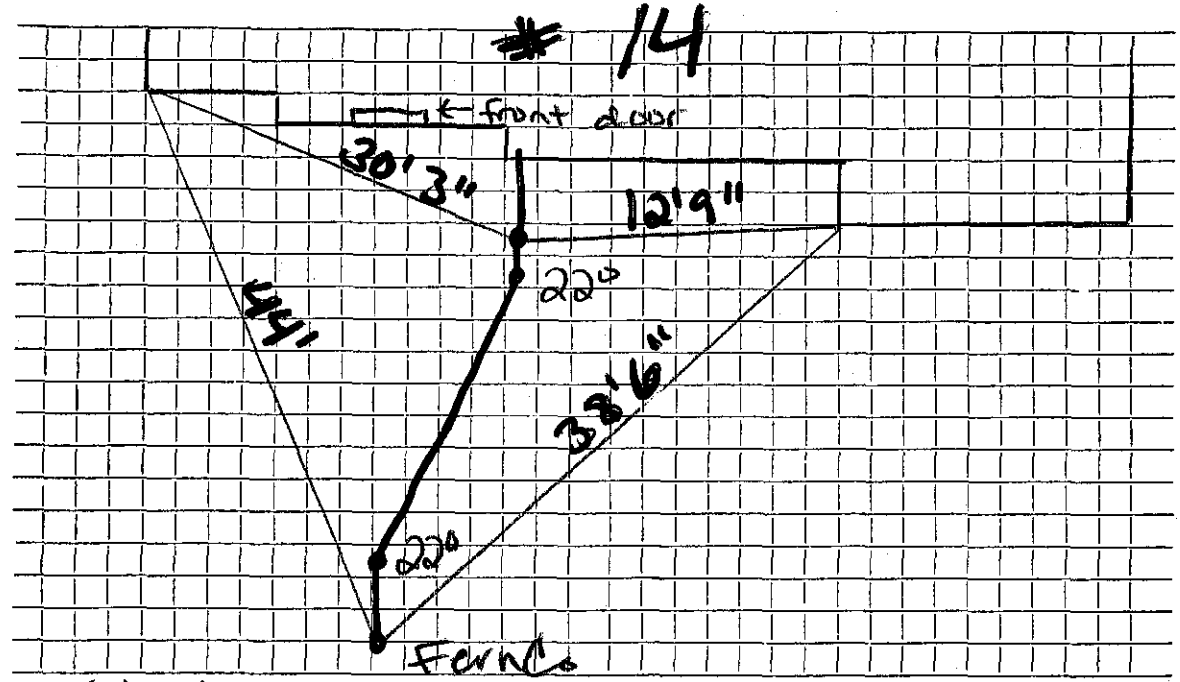

Connection made in ... Woodcliffe Rd Street

Work completed

Remarks:
.....
.....