

Service No.

Name NANCY FREEMAN

Address 15 WOODCLIFFE ROAD

Location

Size of Main

Size 6"

Location


Repair—Renewal—New Service — PERMIT NO 1162

Date	Material	Amount	Total	Date	Amount
OCT 20	84' 6" PVC				
"	1-4" CLEAROUT				
"	1-22° ELBOW				
"	1 FERNCO				

DATE 10-20-98

TOWN OF LEXINGTON — BOARD OF PUBLIC WORKS
SEWER DIVISION

Sketch of Service Here

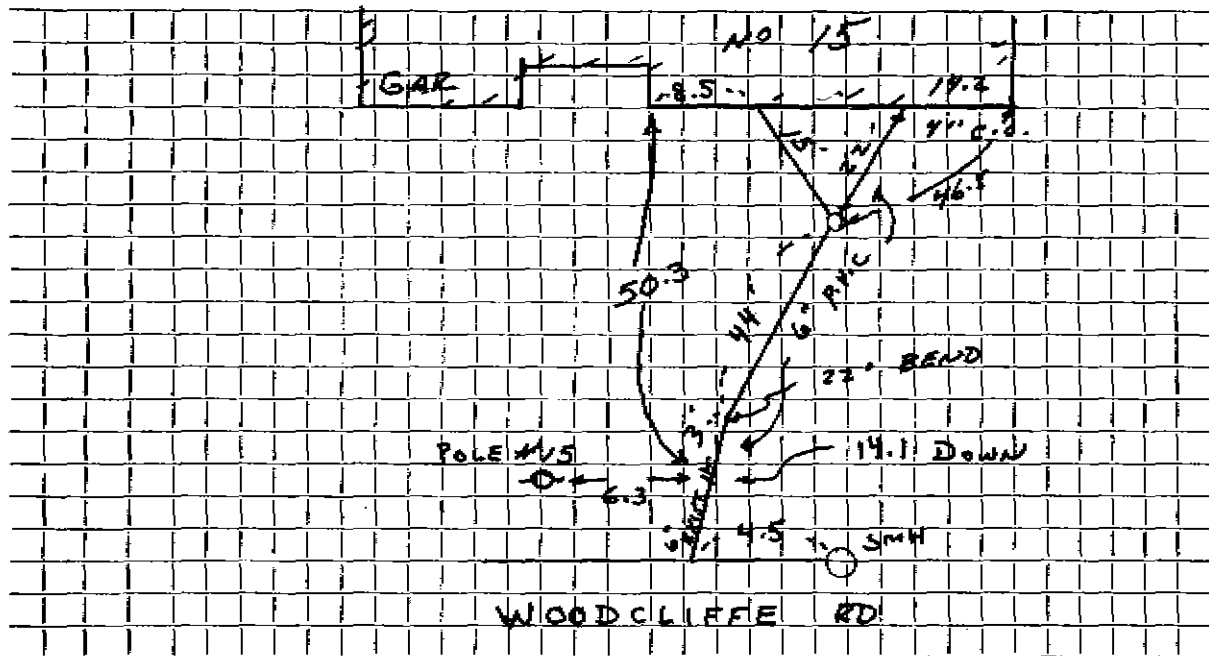

Connection made in WOODCLIFFE ROAD Street. Work completed P.H.D. CONNECTION

Remarks:

FIELD BOOK 98-2


T.M.

DATE _____

TOWN OF LEXINGTON — BOARD OF PUBLIC WORKS

SEWER DIVISION

Sketch of Service Here

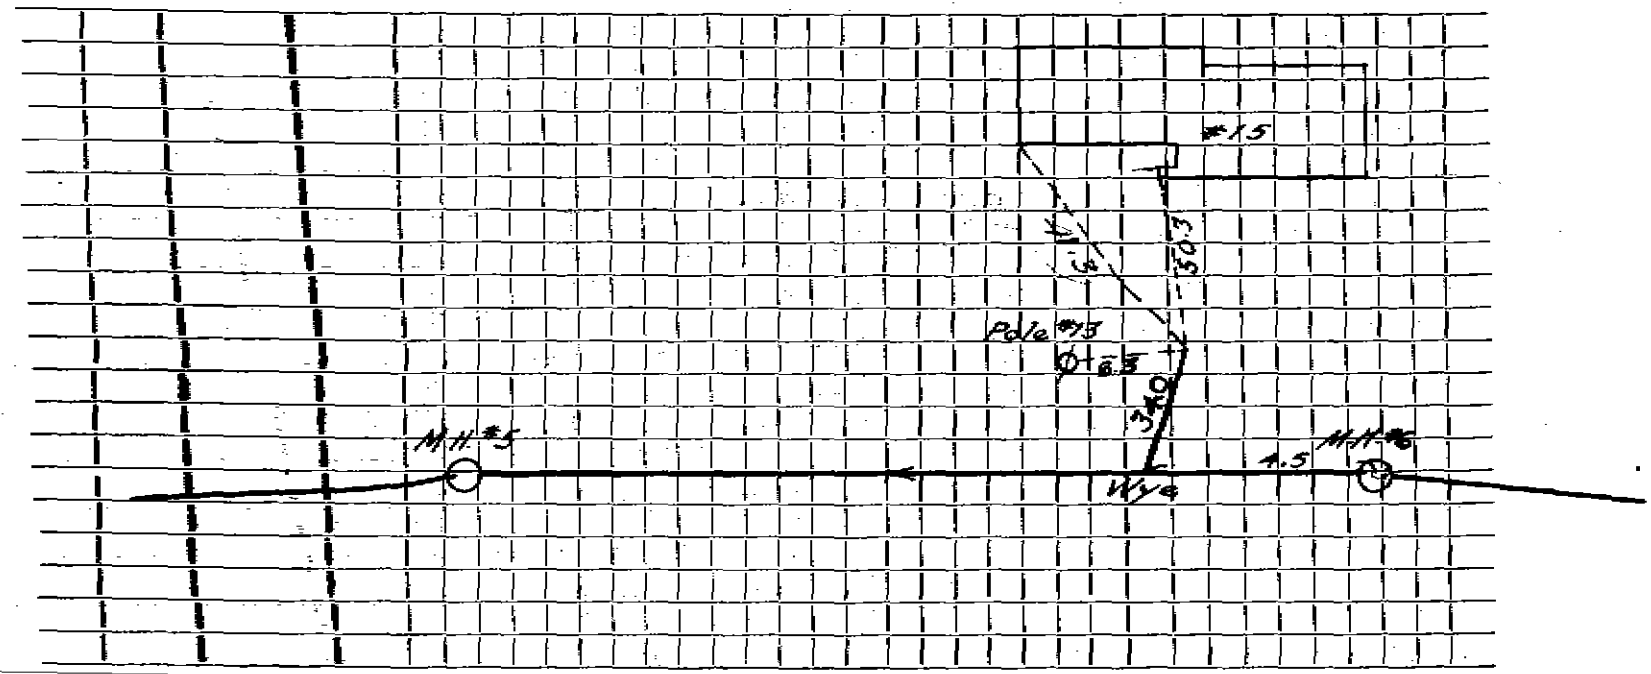

Connection made in Street: Work completed

Remarks:
.....
.....