


DATE 8/3/2019

TOWN OF LEXINGTON — BOARD OF PUBLIC WORKS
SEWER DIVISION

Sketch of Service Here

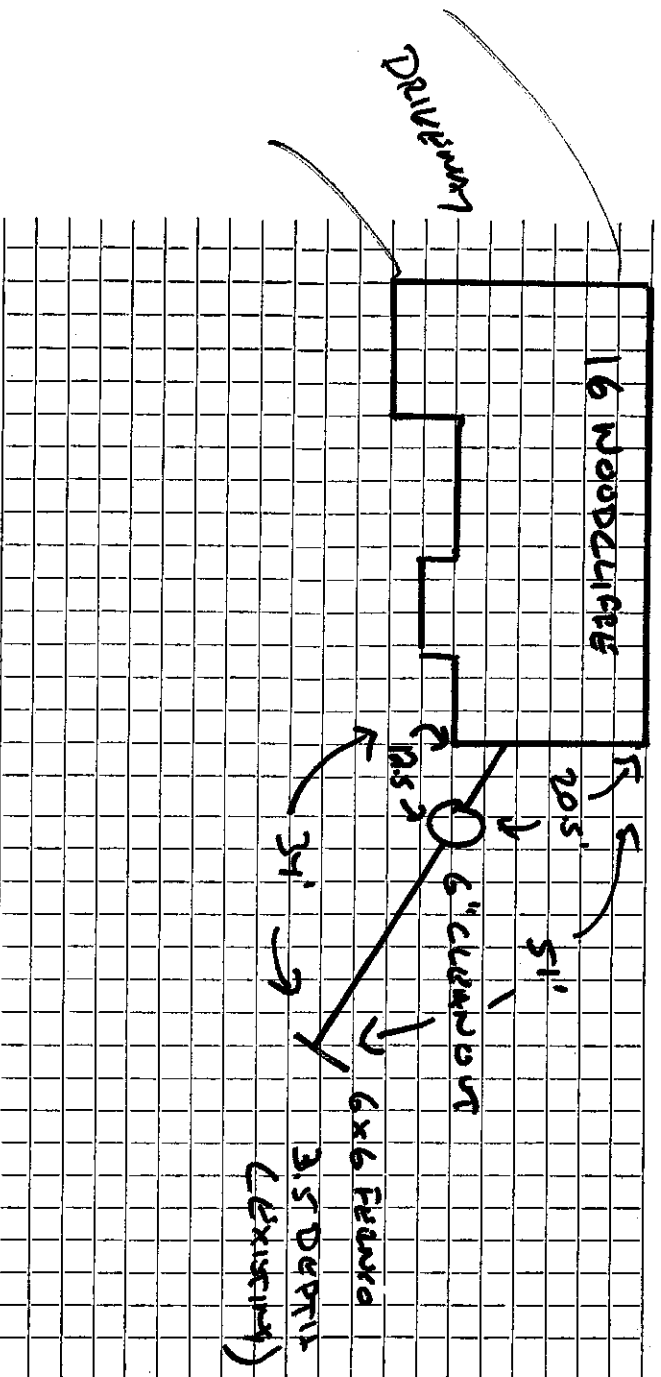

Connection made in WOODCLIFFE Street. Work completed

Remarks:

