


DATE _____

TOWN OF LEXINGTON — BOARD OF PUBLIC WORKS

SEWER DIVISION

Sketch of Service Here

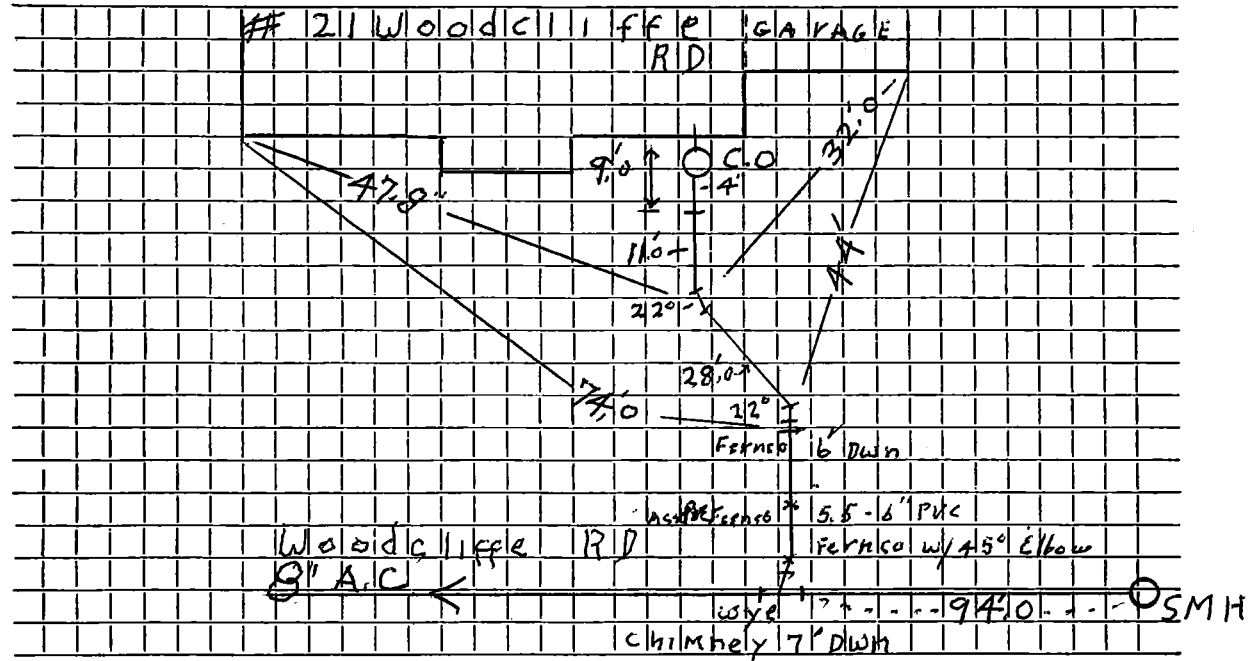

Connection made in Street. Work completed 8/9/10

Remarks: I.N.F.O. @ Sewer Main off. of S. Tre. C.A.V.C.