


DATE JAN 26 1998

TOWN OF LEXINGTON — BOARD OF PUBLIC WORKS

SEWER DIVISION

Sketch of Service Here

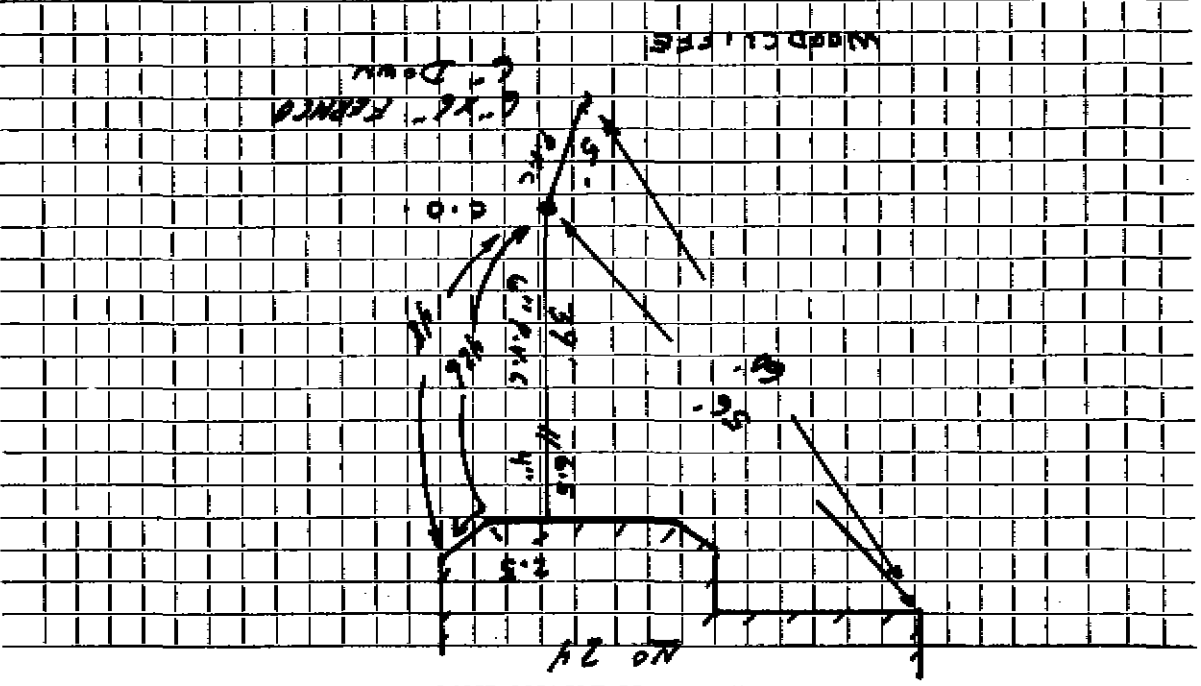

Connection made in WOODCLIFFE RD. Street. Work completed I.M. McLAUGHLIN

Remarks:

FIELD BOOK 98-1

TAM

Name John MacIver

Service No. 92

Address 24 Woodcliffe Road

Location

Kind of Pipe Russell A. Sibley Permit #383

Size

Size of Main

Repair—Renewal—New Service

Location


MAY 2 1960

Date	Material	Amount	Total	Date	Amount
2-8-65	43' 6" Transite pipe @5.00		215.00	4-9-65	315.00
3-10-66	58' 6" Transite pipe				
2/8/65	43.65				

DATE _____

TOWN OF LEXINGTON — BOARD OF PUBLIC WORKS
SEWER DIVISION

Sketch of Service Here

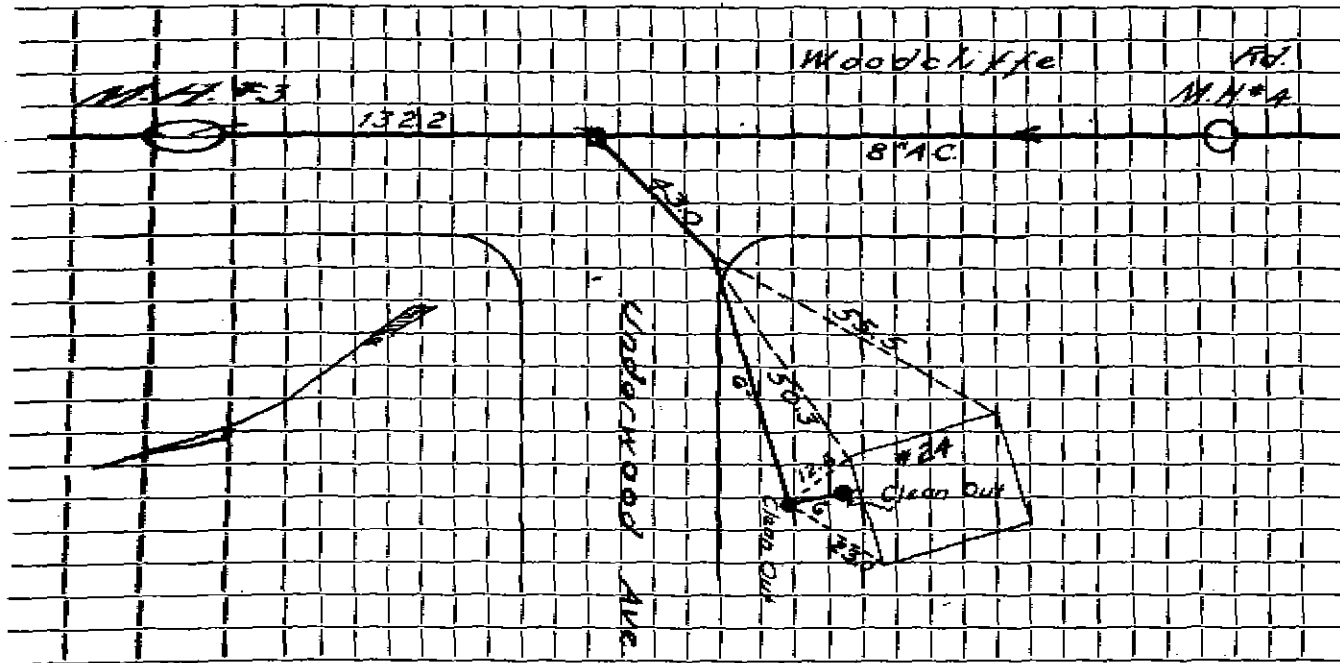

Connection made in Street. Work completed

Remarks: