


DATE _____

TOWN OF LEXINGTON — BOARD OF PUBLIC WORKS

SEWER DIVISION

Sketch of Service Here

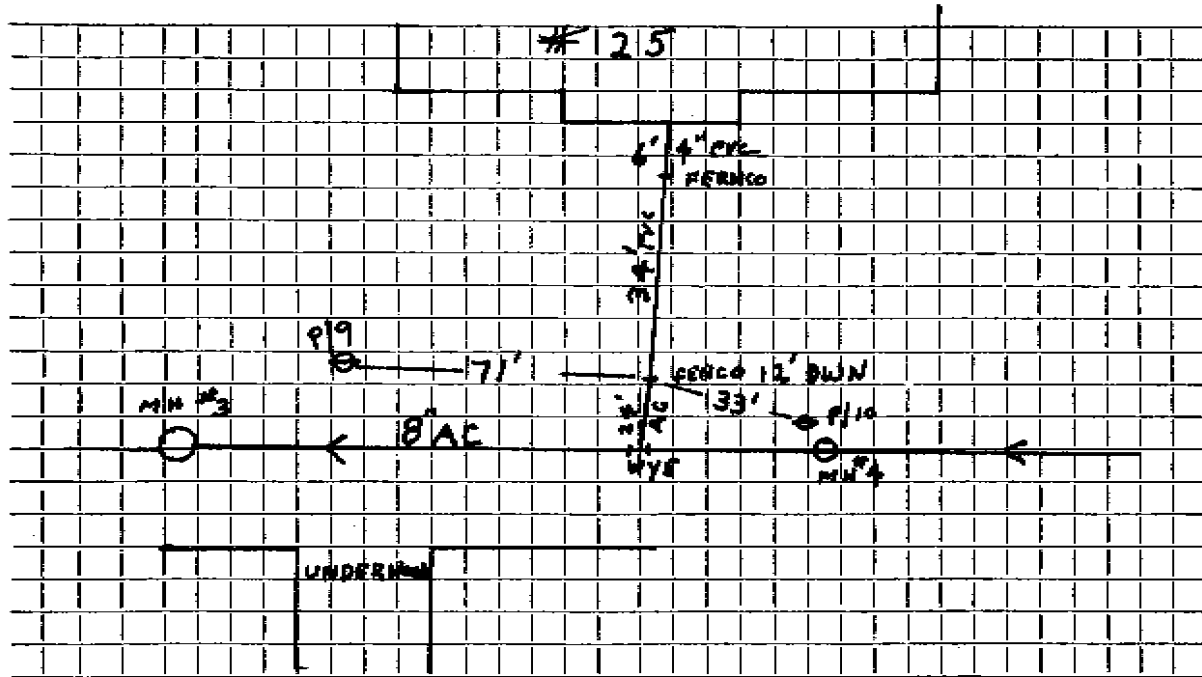

Connection made in WOODSLIFFE RD Street. Work completed 8/27/98

Remarks: DALE