

Name Albert Halprin

Service No. 73

Address 31 Woodcliffe Road

Location

Kind of Pipe

Size

Size of Main

~~Repair/Alteration~~ New Service Kirkland #4801


Location

Date	Material	Amount	Total	Date	Amount
2/9/65	35' 6" Transite pipe @ \$5.00 (to Marlboro Road)		175.00	11-24-88	Deposit 175.00
	29' 6" Transite pipe @ \$5.00 (to Woodcliffe Road)		145.00		
10/24/88	65' 6" PVC				
	3 22° Bend				
	1 4 x 6 Fernco				
	1 AC to PVC Fernco				
DEC 28, 1998	Service put in to foundation				
GGEM	1- 4" x 6" PVC to PVC adapt				
	30' 6" PVC				
	Service comes out to Marlboro Rd				

DATE \_\_\_\_\_

**TOWN OF LEXINGTON — BOARD OF PUBLIC WORKS**  
**SEWER DIVISION**

Sketch of Service Here

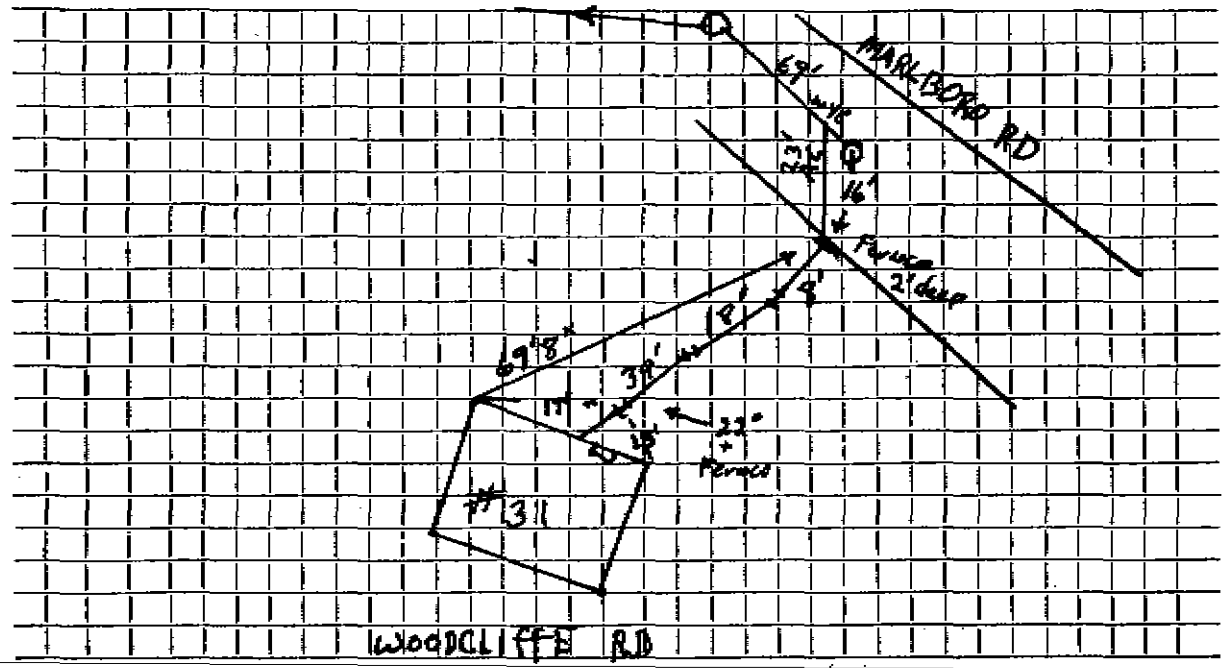

Connection made in ..... Street. Work completed .....


Remarks: AC. EDGE OF RD TO MAIN .....

.....

.....

Owner Mark Barras / New England Coast  
Contractor James M. Melnyk Inc  
Address 31 woodcliffe Rd Wex.  
DATE July 4, 1999

Sewer

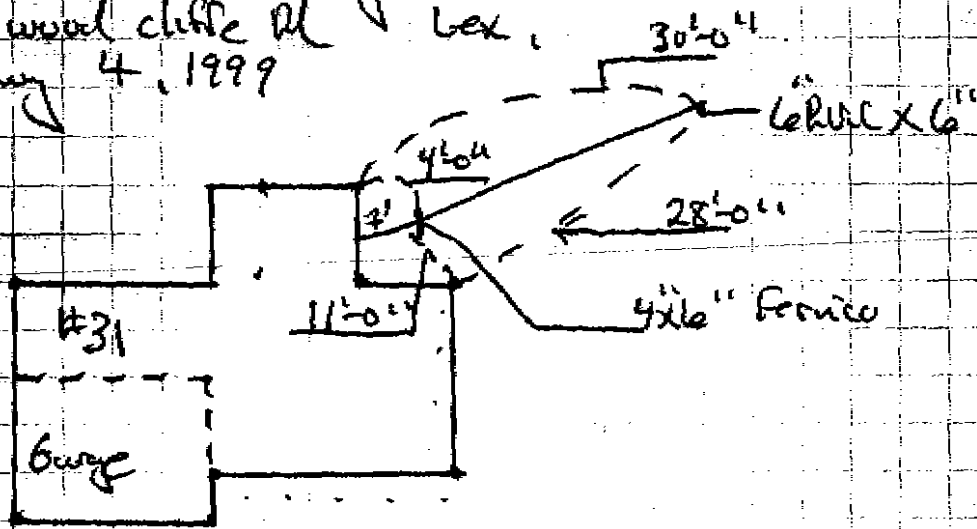

woodcliffe Rd

MARK BARRAS  
 31 WOODCLIFF RD  
 WEXFORD MA 01980