

Name

Service No.

Address

34 Woodcliffe

Location

Kind of Pipe

Size

Size of Main

Repair Renewal New Service

Location

Date	Material	Amount	Total	Date	Amount
4-25-02	SERVICE RENEWED INSIDE				AC outside
	10'-4" PVC				
	4 1/2'-6" PVC				

SERVICE RENEWED INSIDE

AC outside

10'-4" PVC

4 1/2'-6" PVC

4x 2 1/2" dia

6x

REG. NO. E9149

DATE 1-1-59

Gringeri Bros Trans Co Inc
7 Slocum Rd
Lexington

Cad--1958 Se 6p 4d

8

VEHICLE DESCRIPTION

REG. OFF. OR WGT.

581-089675

1403627

VEHICLE IDENT. NO.

ENG. NO.

Lexington

3400

AMPT Pol

mh


INS. CO.

218.04

DATE _____

TOWN OF LEXINGTON — BOARD OF PUBLIC WORKS
SEWER DIVISION

Sketch of Service Here

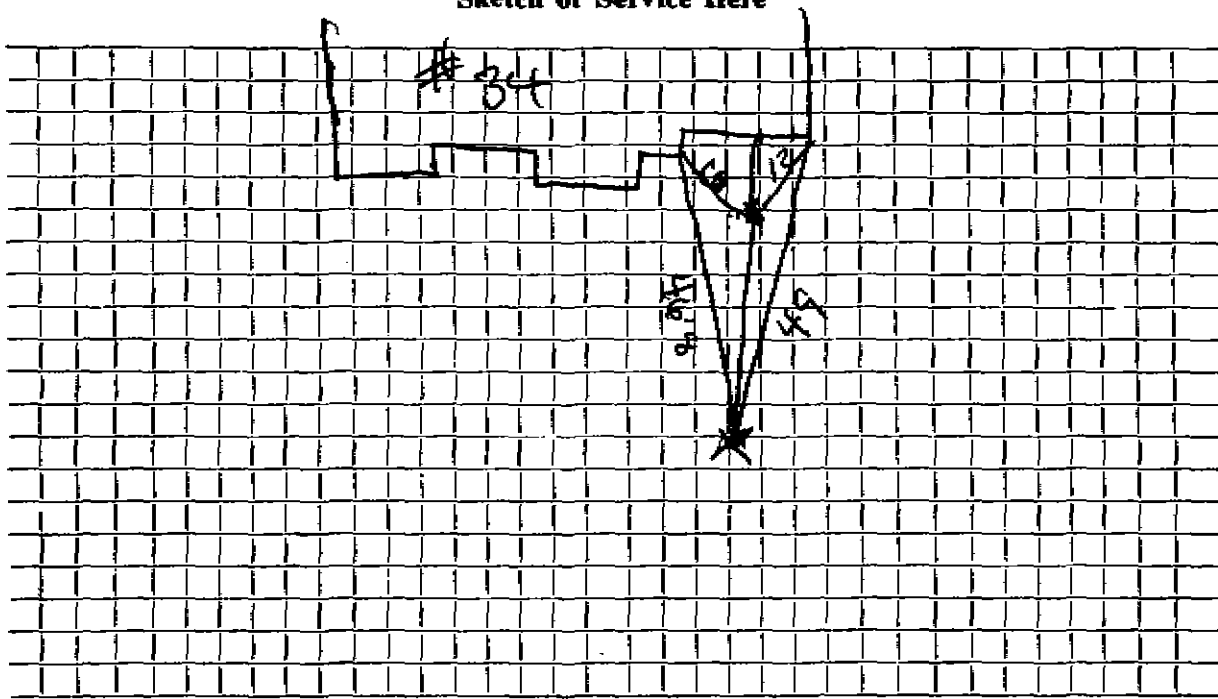

Connection made in Street. Work completed

Remarks:
..... Old house torn down - gas is 6" to left of sewer
..... facing house

#32 WOODCHIP

9'4"

7'6"

15'9"

← CLEAN OUT

6'3"

Driveway

TRANSITE TO CAST IRON JOINT

REG.
NO.

E9147

DATE

1-1-59

FEE

Gringeri Bros Trans Co Inc
7 Slocum Rd
Lexington

Cad--1958 Se 6p 4d

8

VEHICLE DESCRIPTION

NO. CYL OR WGT.

58M-089675

1403627

VEHICLE IDENT. NO.

ENG. NO.

Lexington

3400

Amer Pol

mh

GARAGE

INS. CO.

218.04

