


SEWER DIVISION

Sketch of Service Here

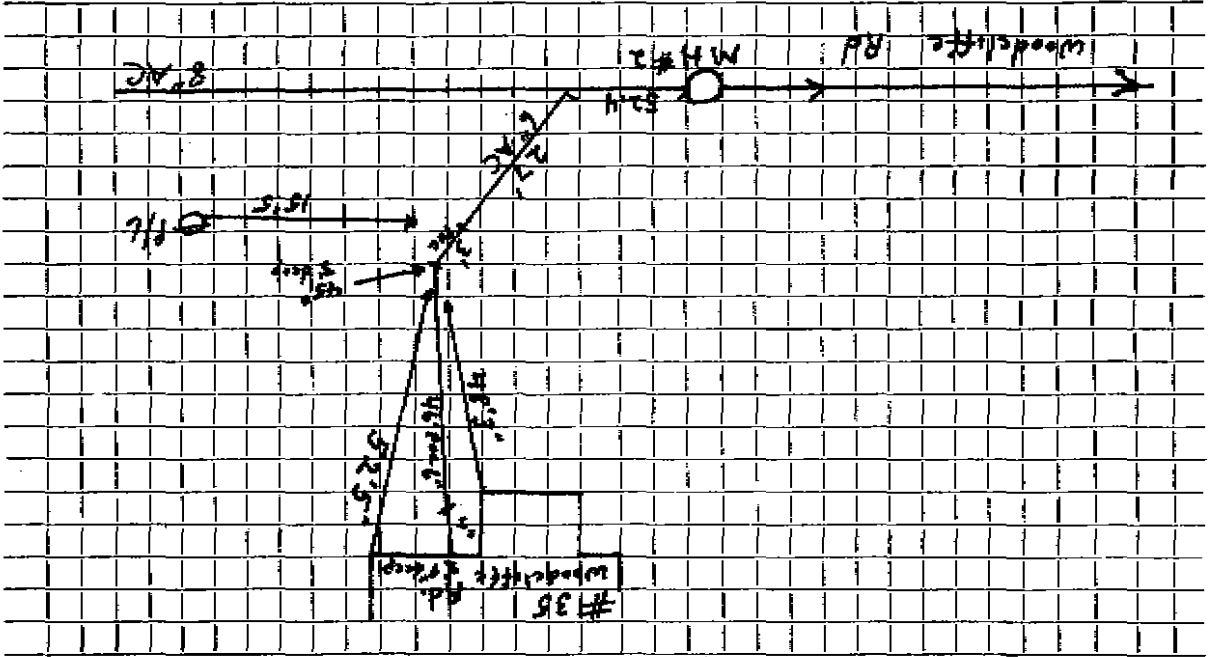

Connection made in _____ Street. Work completed _____


Remarks: _____

TOWN OF LEXINGTON — BOARD OF PUBLIC WORKS

SEWER DIVISION

DATE _____

Sketch of Service Here

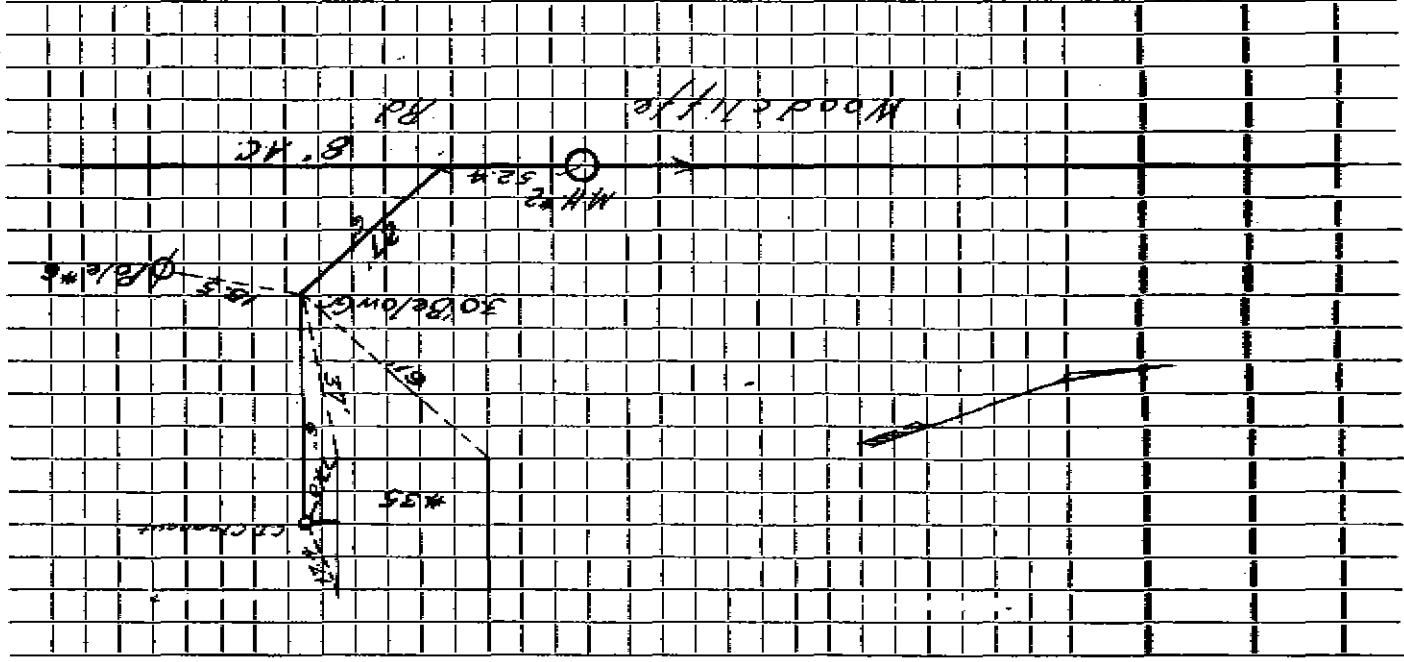

Connection made in _____

Street _____

Work completed _____

Remarks: _____