


DATE 8/5/94

TOWN OF LEXINGTON — BOARD OF PUBLIC WORKS
SEWER DIVISION

Sketch of Service Here

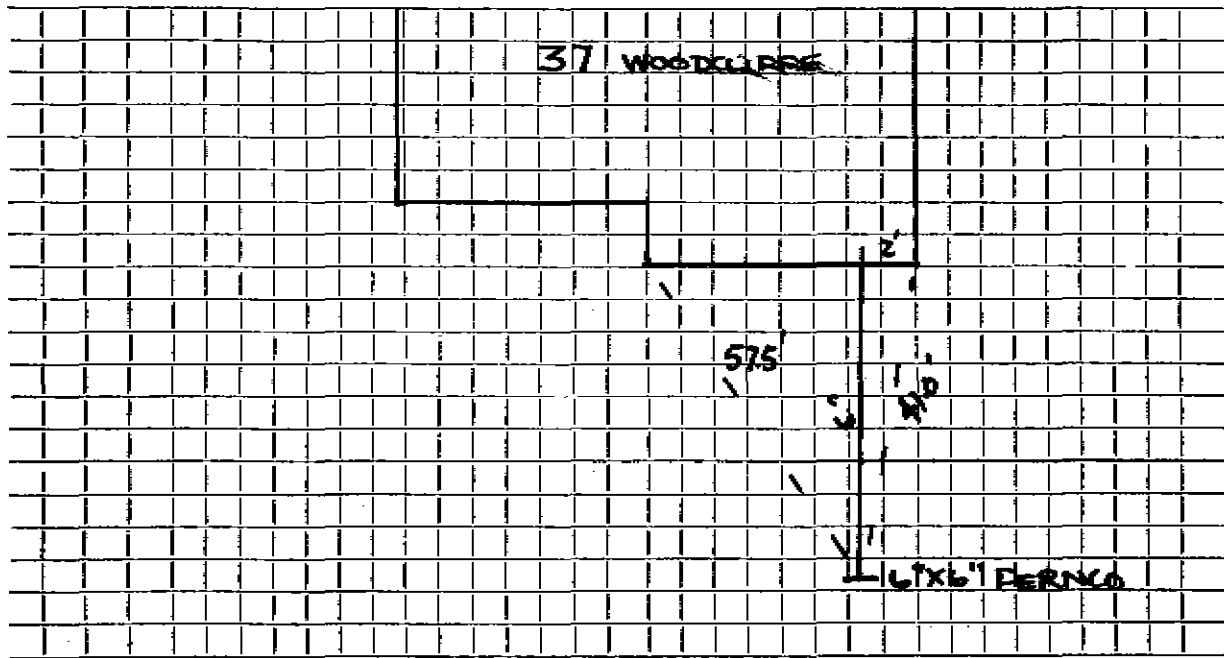

Connection made in Street. Work completed

Remarks:
.....
.....

Name Stuart A. Campbell

Service No. 4

Address 37 Woodcliffe Road

Location

Kind of Pipe

Size

Size of Main

Repair—Renewal—New Service Valeri #544

Location Man 5-8-67


Date	Material	Amount	Total	Date	Amount
2-9-65	27' .6" Transite pipe @5.00		135.00	2-8-67	Deposit
2/17/67	15' 6" Transite pipe				
	40' 4" Cast Iron Pipe				

DATE _____

TOWN OF LEXINGTON — BOARD OF PUBLIC WORKS

SEWER DIVISION

Sketch of Service Here

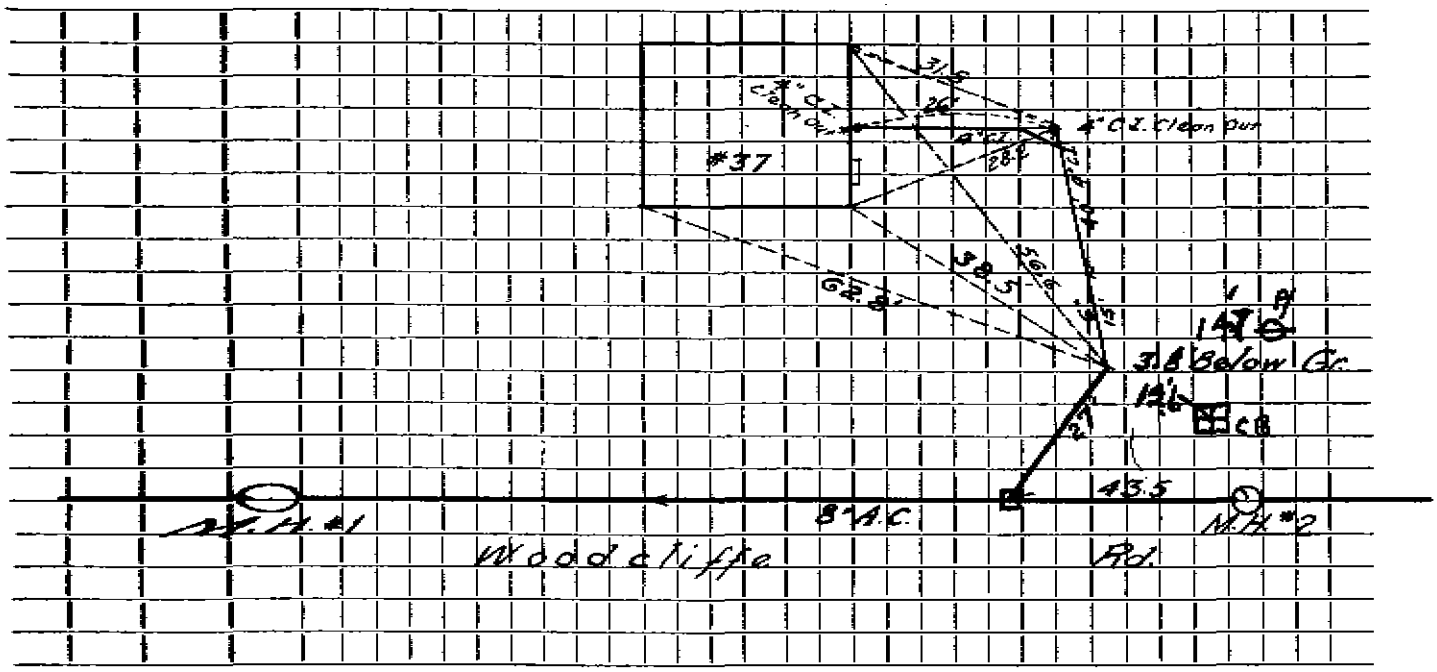

Connection made in _____ Street. Work completed _____

Remarks: 6/23/94. Redmond CAPED. SEWER PIPE, DISCONNECTED WATER AT CURB.