




DATE May 19, 2020

TOWN OF LEXINGTON — BOARD OF PUBLIC WORKS  
SEWER DIVISION

Sketch of Service Here

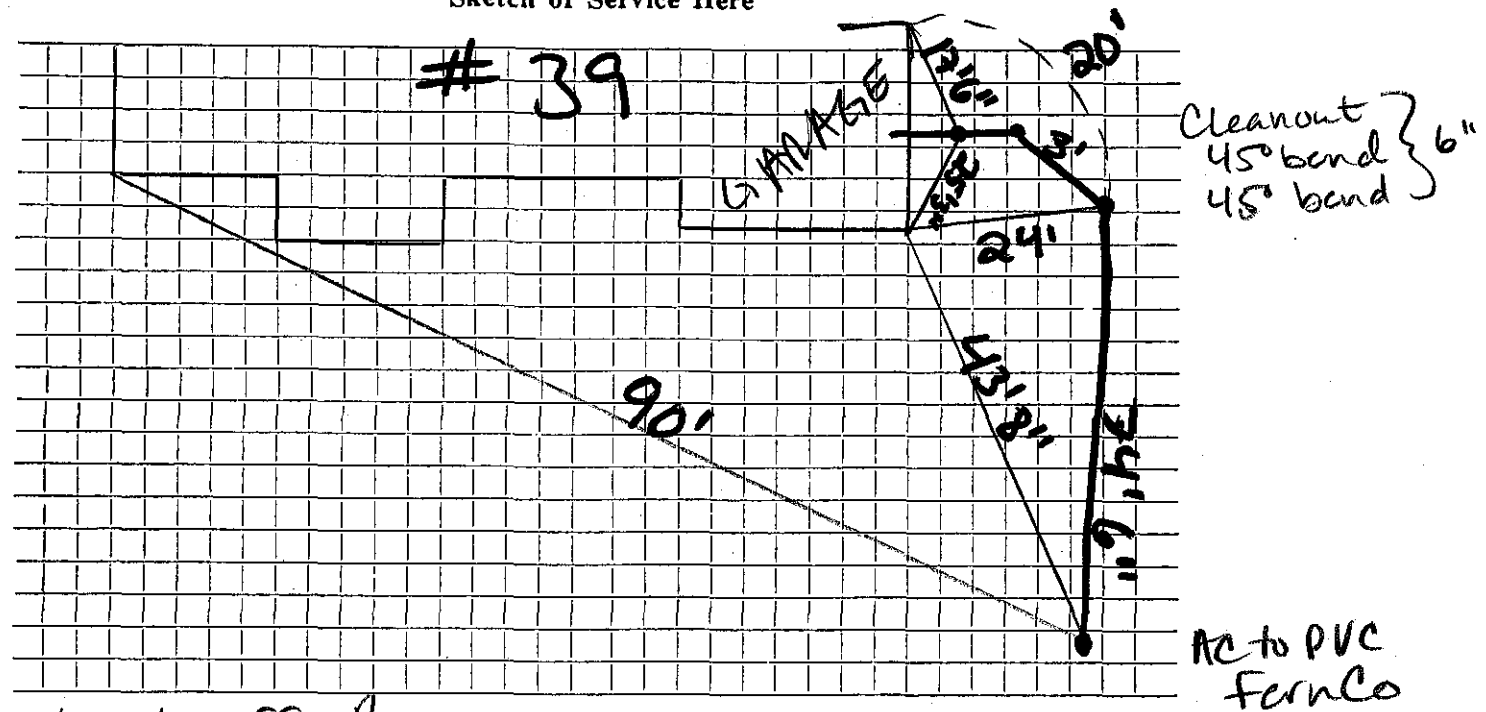

Connection made in Woodcliffe Ave Street. Work completed .....

Remarks: .....

depth @ stub connection = 4' 6"

.....