




DATE 5/2/00

TOWN OF LEXINGTON — BOARD OF PUBLIC WORKS

SEWER DIVISION

Sketch of Service Here

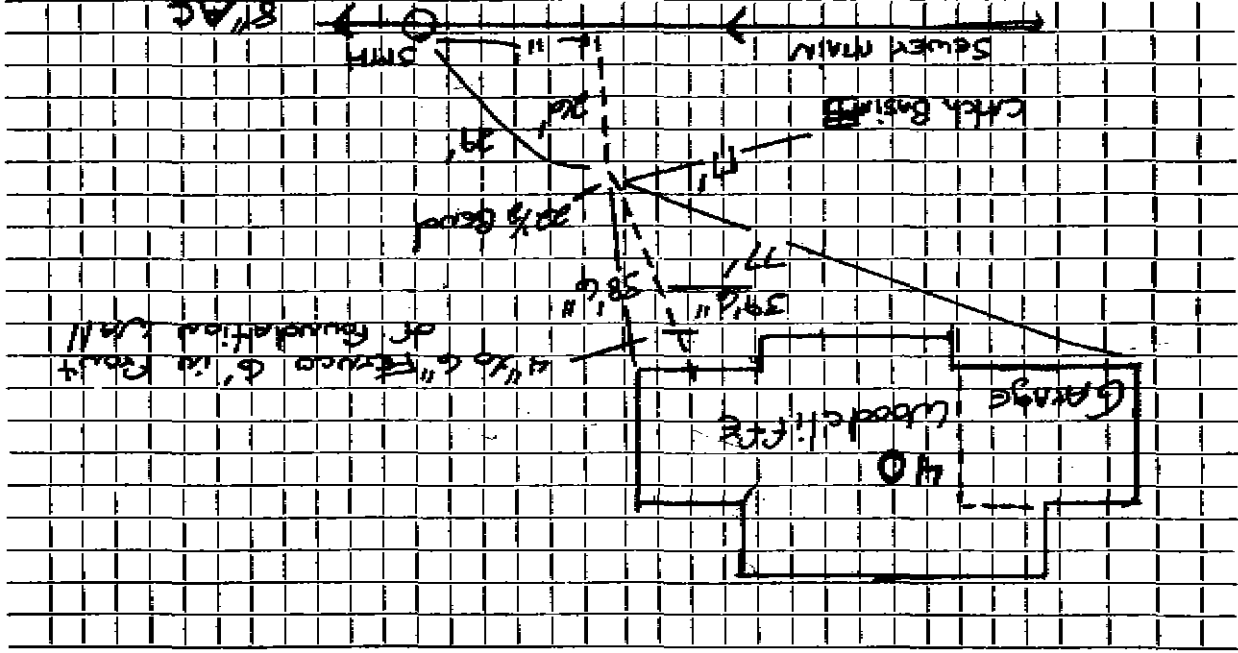

Street. Work completed

Connection made in

Remarks: