


DATE

TOWN OF LEXINGTON — BOARD OF PUBLIC WORKS

SEWER DIVISION

Sketch of Service Here

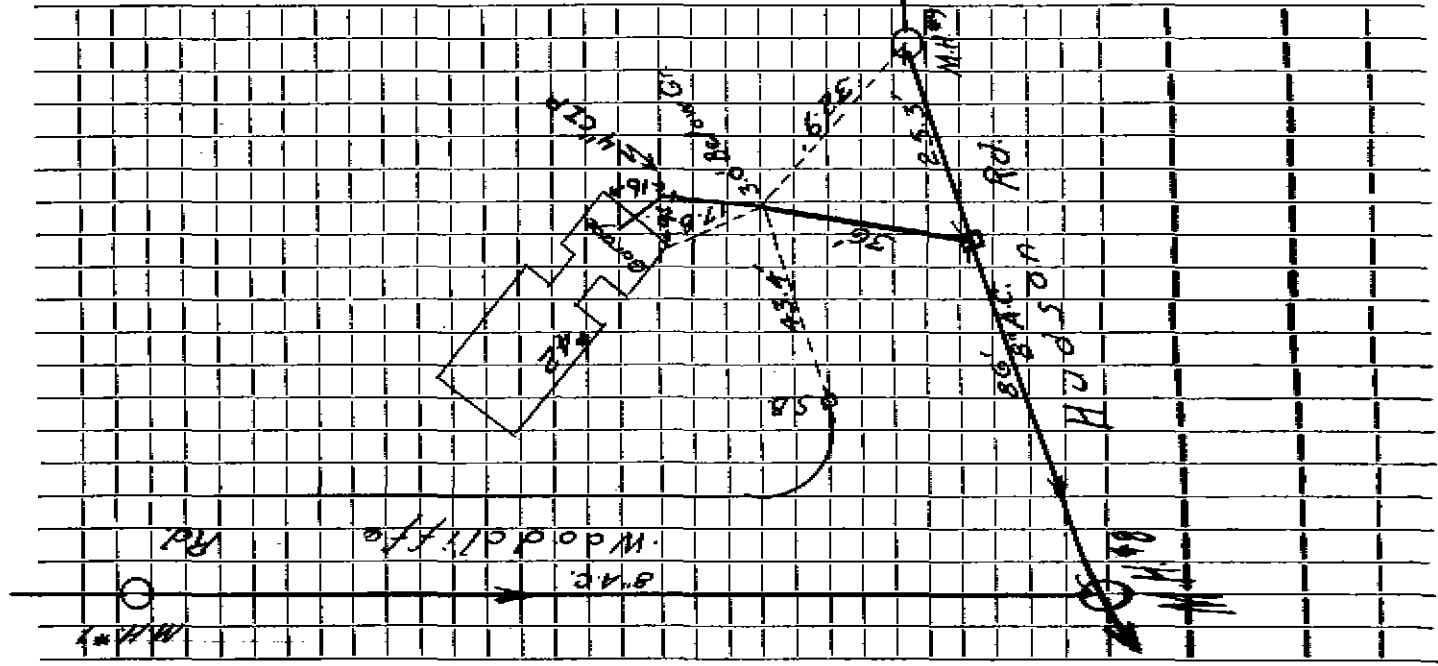

Connection made in Hudson Rd Street Work completed 12-8-82

Remarks:

Service provided at edge of land
Ceiling - 6" PVC - 2 6"x6" PVC to AC frames