

Name W. L. Garside

Service No. 96

Address 43 Woodcliffe Road

43 Woodcliffe Rd.

Location

Kind of Pipe

Size

Size of Main

~~Repair~~ ~~Renewal~~ - New Service Lexington Sewerage Co. Permit #384

Location JUL 25 1966


Date		Material	Amount	Total	Date		Amount
5-18-65		20' 6" Transite pipe @5.00		100.00	7-14-65	Deposit	100 00
5/2/65		20' 6" S					

DATE

TOWN OF LEXINGTON — BOARD OF PUBLIC WORKS

SEWER DIVISION

Sketch of Service Here

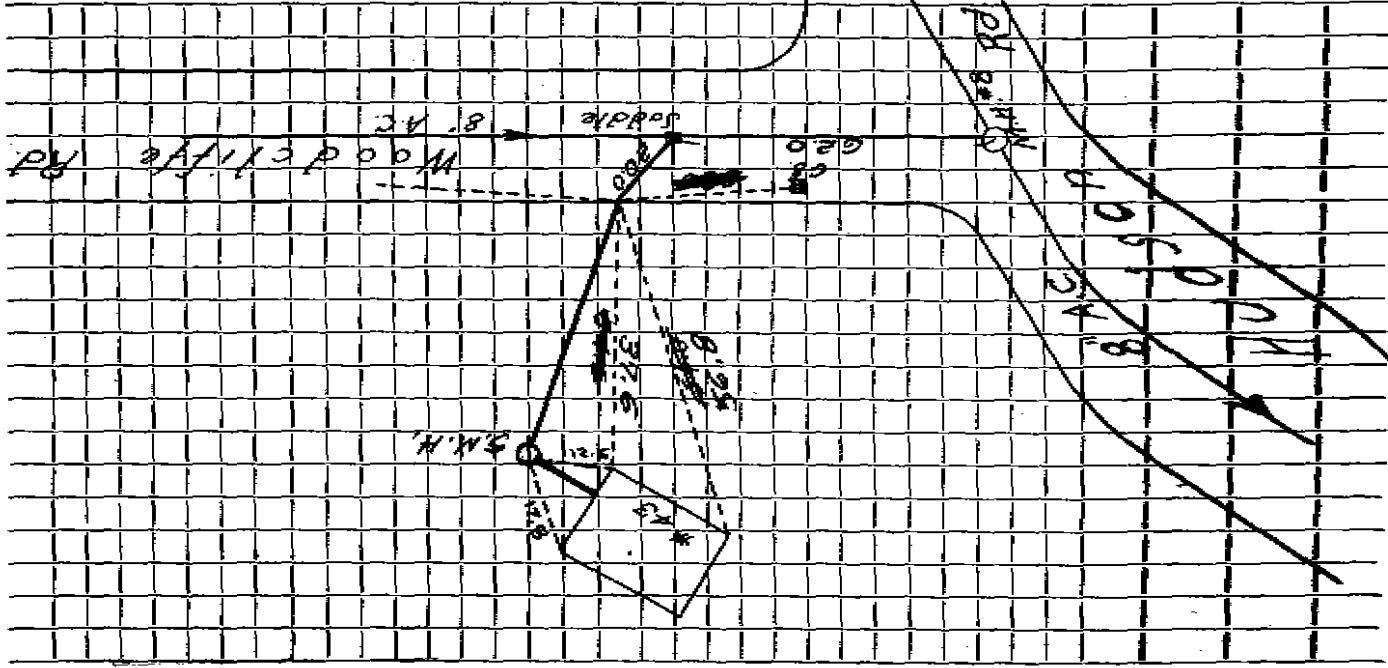

Connection made in

Street. Work completed

Remarks: