

Name Robert E. Bouyer

Address 7 Woodcliffe Road

Service P.M.

259

Location

Kind of Pipe Valari Const. Co.

Requirement New Service Permit #4 162

Size of Installation

Location

MAR 14 1960

Amount

Date Material Amount

Total Date

100.00

Eyeset


110.00 6-20-65

2-2-65 22' 6" Transite pipe @5.00
12-21-65 26' 6" Transite pipe

DATE _____

**TOWN OF LEXINGTON — BOARD OF PUBLIC WORKS
SEWER DIVISION**

Sketch of Service Here

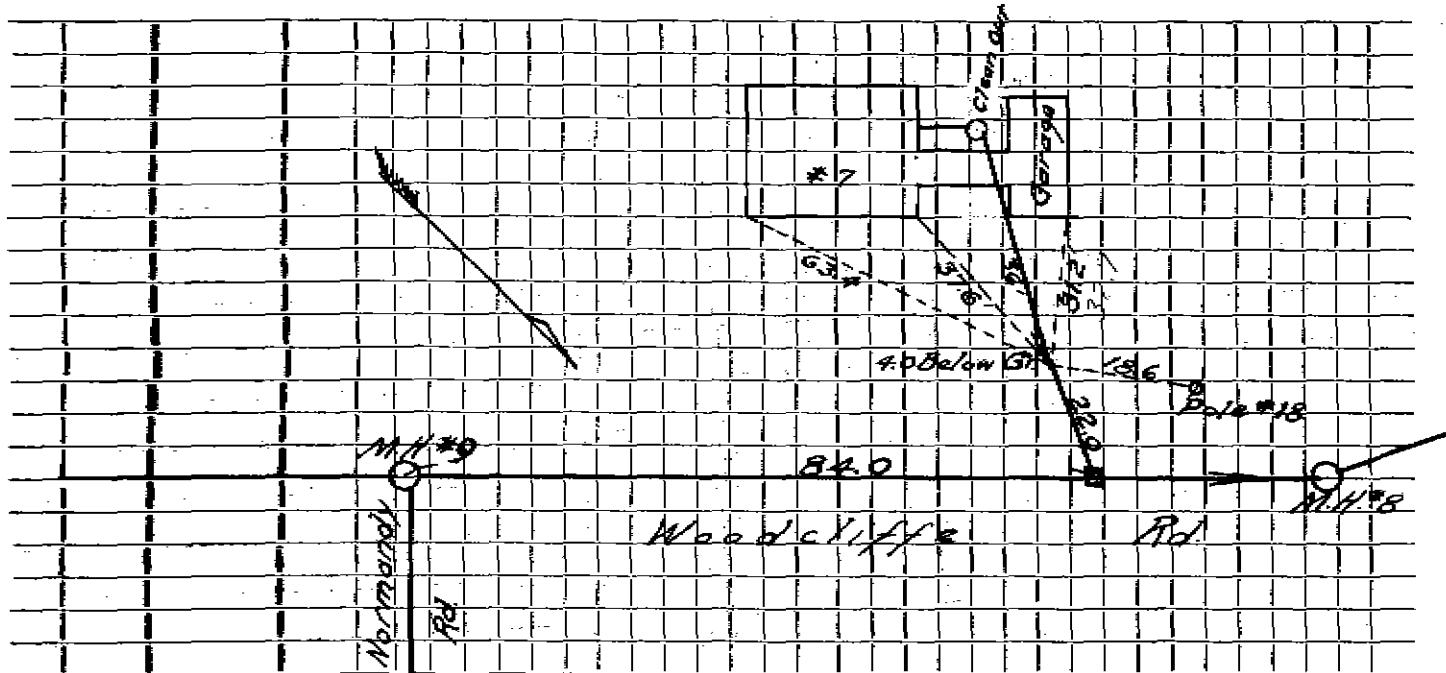

Connection made in Street. Work completed

Remarks: