


DATE 27 AUGUST 1996

TOWN OF LEXINGTON — BOARD OF PUBLIC WORKS
SEWER DIVISION

Sketch of Service Here

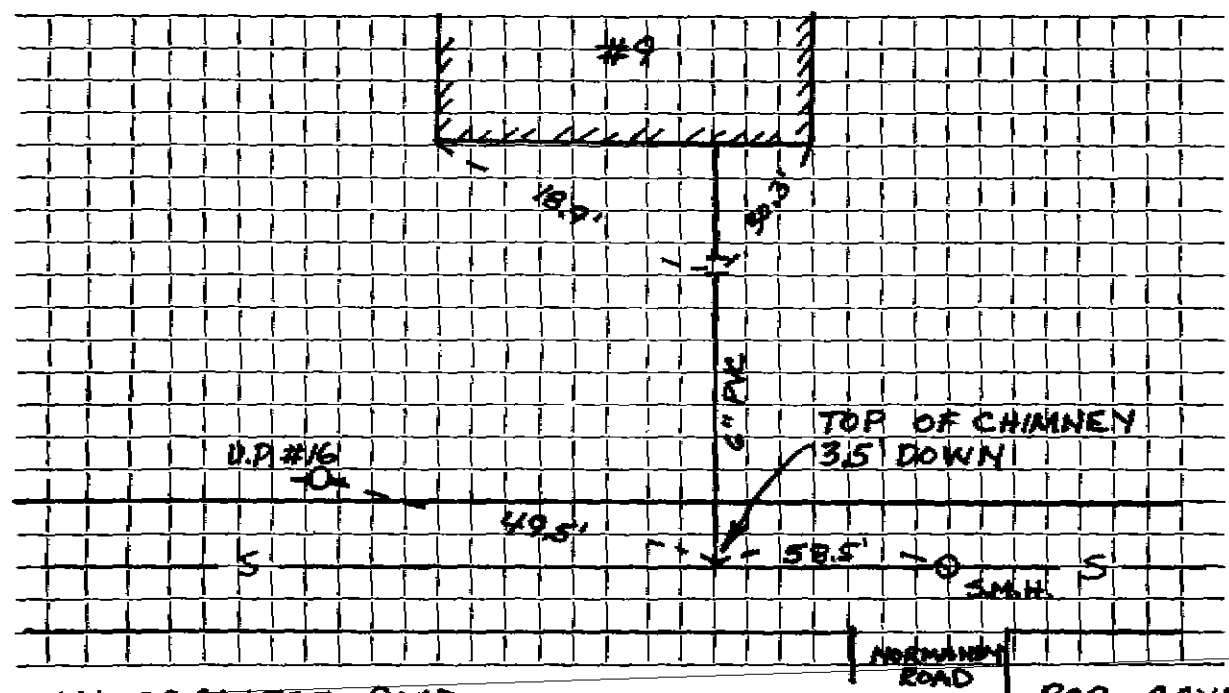

Connection made in WOODCLIFFE ROAD Street. Work completed BOB GAYLOR

Remarks:

BOOK 96-4

