

Name

Service No.

Address 1A WOODLAND RD

Location

Kind of Pipe

Size

Size of Main

Repair—Renewal—New Service


Location

Date	Material	Amount	Total	Date	Amount
9/1/94	5.5 LF 6" PVC				
	30 LF 4" PVC				
	4x6" FRANK				
	4x4" TEE				
	90° ELBOW				

DATE _____

TOWN OF LEXINGTON — BOARD OF PUBLIC WORKS
SEWER DIVISION

Sketch of Service Here

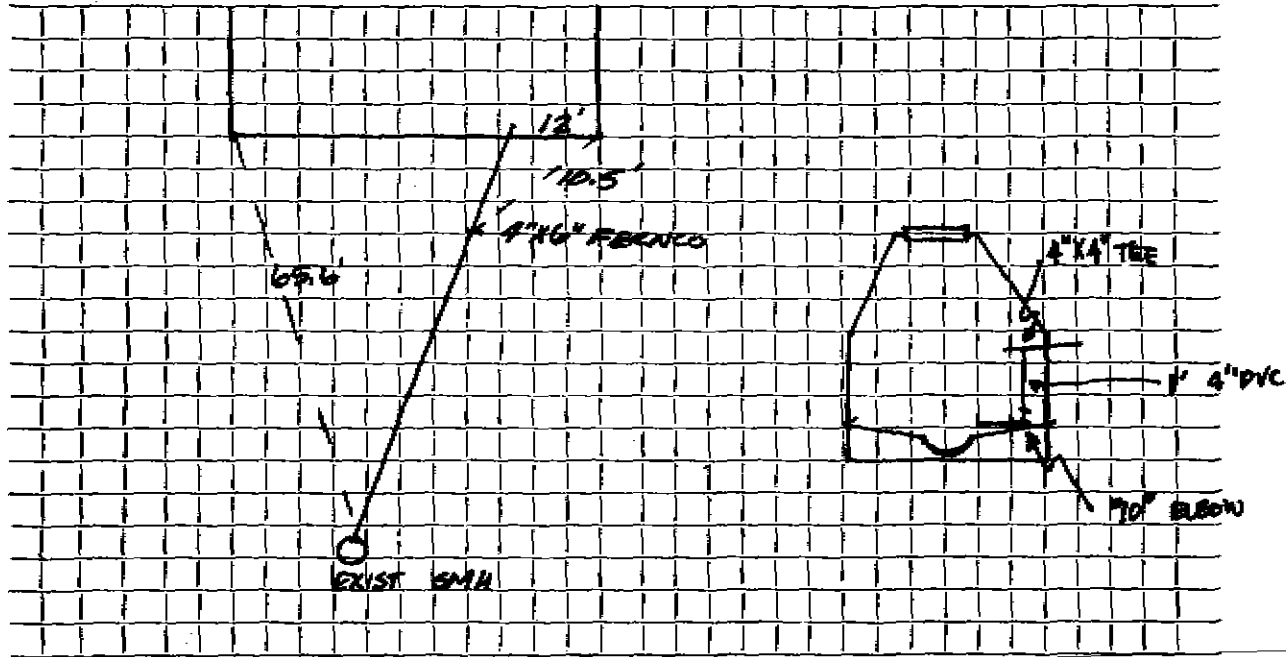

Connection made in Street. Work completed

Remarks:

.....

.....