




DATE 24 SEPT. 1996

TOWN OF LEXINGTON — BOARD OF PUBLIC WORKS  
SEWER DIVISION

Sketch of Service Here

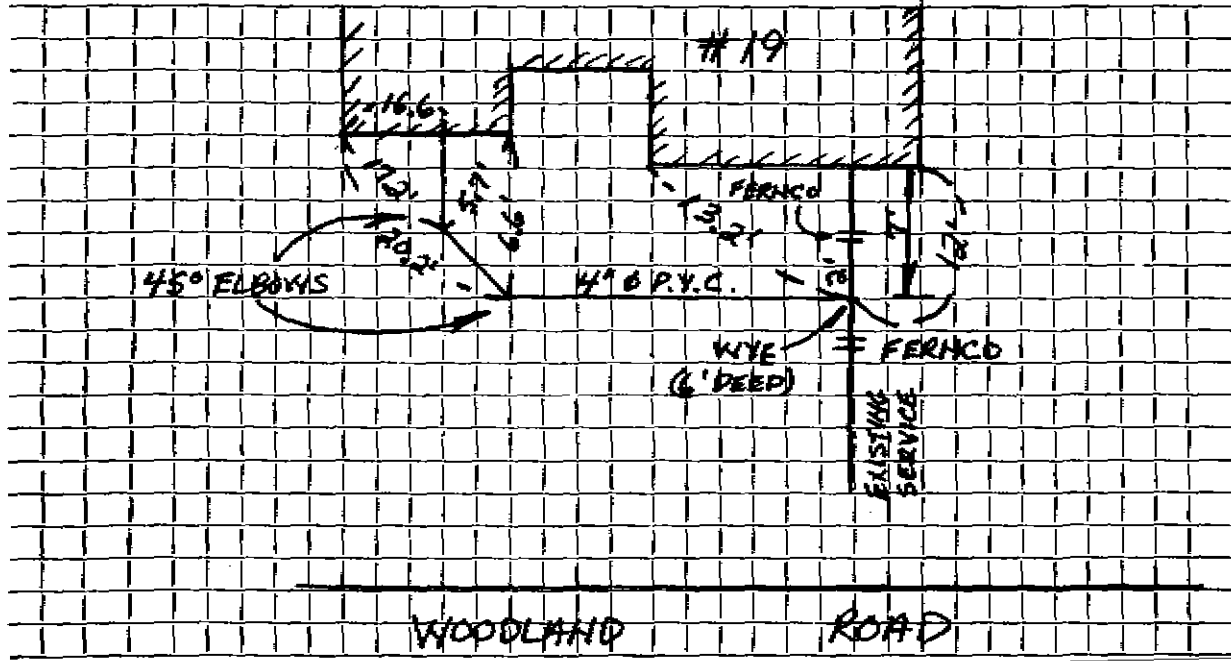

Connection made in WOODLAND ROAD Street. Work completed ARLEX OIL COMPANY

Remarks: .....

BOOK 96-4

T.W.

service to curb - to be charged when connected

Name **Frederick R. Wilson**

Service No. **29**

Address **19 Woodland Road**

**Lexington, Mass.**

Location *Canon 11-14-58*

Kind of Pipe

Size

Size of Main

~~XXXXXXXXXX~~ **New Service**

Location

Date		Material	Amount	Total	Date		Amount
July	1951	Flat Rate		72 00	5-13-58	Deposit	200 00
		INSTALLED BY CONTRACTOR			10-9-58	Paid	5 25
		24' -6" sewer pipe @.342	-48.21				205 25
3/24/58		Labor	66 18				
		10 % Overhead	6 62	72 80			
		10' 6" Transite @	70	7 00			
		16' 6" Cast Iron Pipe@	1 96	31.36			
		10' 6" V.C. Pipe		4 35			
		1 6" 1/8 Clay Bend		1 24			
		2 Hrs. Town Shovel @	6.50	13 00			
		2 Hrs Trucking @	75	1 50			
		2 Hrs Pump @	1 00	2 00			
		Labor		205. 25			

*Bill sent Oct 14 1958*

**TOWN OF LEXINGTON—DEPT. OF PUBLIC WORKS**  
**SEWER DIVISION**

DATE .....

NO. ....


The undersigned applies for the construction of a particular sewer connecting No. ....  
Street and hereby agrees to comply with the Rules and Regulations governing the construction and use of Particular  
Sewers, as now or at any future time established by the Board of Selectmen.

Am't of estimate \$.....

Am't Paid \$.....

..... Owner

**Sketch of Service Here**

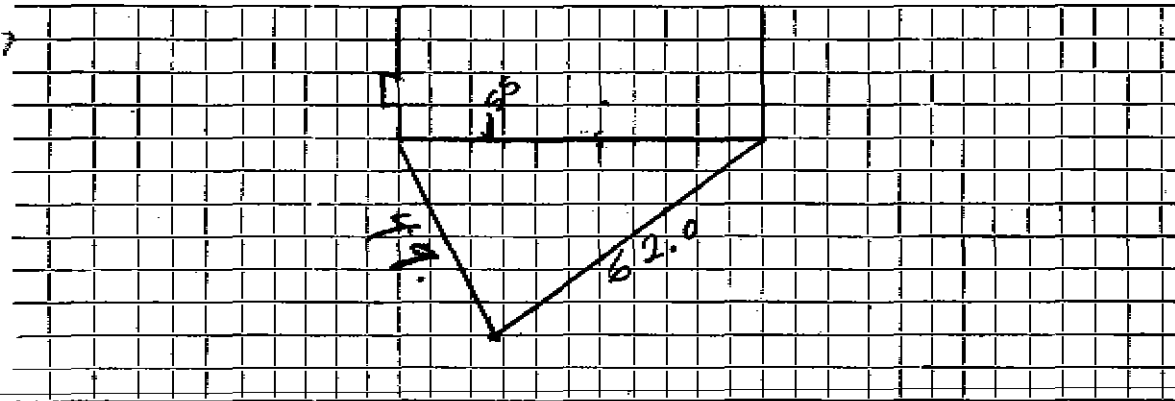

Connection made in ..... Street.

Work completed ..... 19..

Remarks: