

Name J. S. Mason Whitney

Service No. 179

Address 21 Woodland Road

Location Committed 4-2-56

Kind of Pipe

Size

Size of Main

Repaired ~~Repaired~~ — New Service

Location

Date	Material	Amount	Total	Date	Amount
1-5-56	Labor	35 80		1-5-56	300 00
1-6-56	Labor	53 70	89 50	4-2-56	139 41
	10% overhead		8 95		160 59
	24" - 6" sewer pipe @ .50		12 00		
	2 - 6" Elbows @ 1.35		2 70		
	Joint compound		1 44		
	6 hrs. Town Shovel @ 6.00		36 00		
	6 hrs. trucking		4 59		
	2 hrs. Compressor @ 2.75		5 50		
			160 59		
	Labor				

**TOWN OF LEXINGTON—DEPT. OF PUBLIC WORKS
SEWER DIVISION**

DATE.....

NO.....


The undersigned applies for the construction of a particular sewer connecting No.....
Street and hereby agrees to comply with the Rules and Regulations governing the construction and use of Particular
Sewers, as now or at any future time established by the Board of Selectmen.

Am't of estimate \$.....

Am't Paid \$.....

..... Owner

Sketch of Service Here

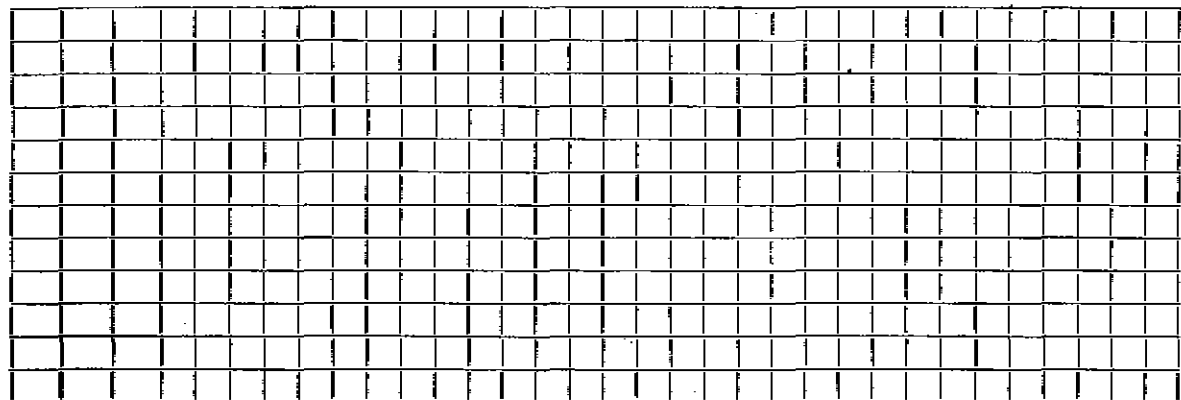

Connection made in Street.

Work completed.....19..

Remarks:

service to curb - to be charged when connected.

Name

Service No.

Address

21 Woodland Road

Lexington, Mass.

Location

Kind of Pipe

Size

Size of Main

~~Replace Existing~~ New Service

Location

Date		Material	Amount	Total	Date	Amount
July 1951		Flat Rate:		72.00		
		INSTALLED BY CONTRACTOR				
		24' - 6" sewer pipe @ .342	- \$8.20			
		Labor				

