

Name Vinton W. Mason

Service No. 70

Address 22 Woodland Road

Lexington, Mass.

Location

Kind of Pipe

Size

Size of Main

~~REPAIR WORK~~ New Service

COMMITTED 10-15-51

Location

Date	Material	Amount	Total	Date	Amount
July 1951	Flat rate		129.00	7-17-51	159.00
	INSTALLED BY CONTRACTOR			10-15-51	30.00
	43' -6" sewer pipe @ .342	- \$14.71			129.00
	Labor				

**TOWN OF LEXINGTON—DEPT. OF PUBLIC WORKS**  
**SEWER DIVISION**

DATE .....

NO. ....


The undersigned applies for the construction of a particular sewer connecting No. ....  
Street and hereby agrees to comply with the Rules and Regulations governing the construction and use of Particular  
Sewers, as now or at any future time established by the Board of Selectmen.

Am't of estimate \$ . . . . .

Am't Paid \$ . . . . .

..... Owner

**Sketch of Service Here**

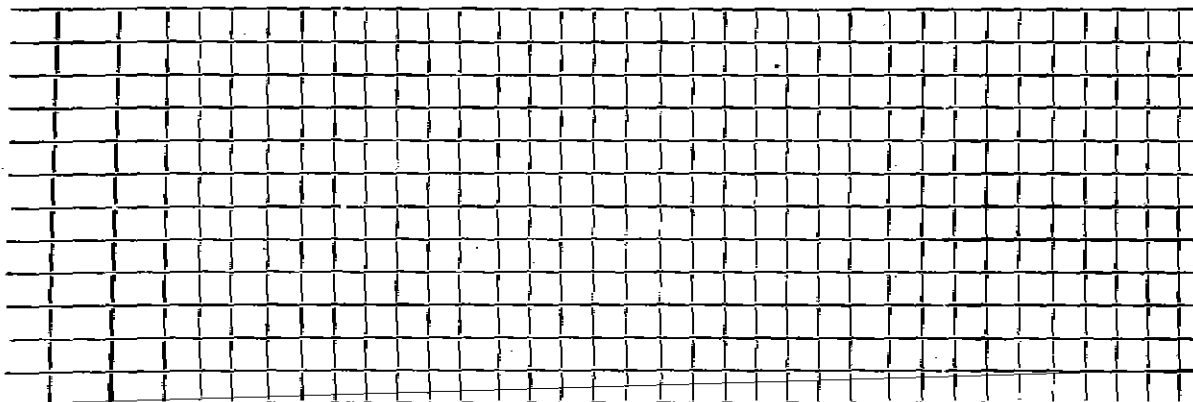

Connection made in ..... Street.

Work completed ..... 19..

Remarks: