

R 22-000

Name Harold E. Manning

Service No. 77

Address 28 Woodland Road

Lexington, Mass.

Location

Kind of Pipe

Size

Size of Main

REPAIRS ~~REPAIRS~~ New Service

COMMITTED 10-15-51

Location

Date	Material	Amount.	Total	Date		Amount
July 1951	Flat rate		138.00	7-15-51	Deposited	160.00
	INSTALLED BY CONTRACTOR			11-15-51	Refunded	22.00
	46' -6" sewer pipe @ .342	-\$15.73				138.00
	Labor					

TOWN OF LEXINGTON—DEPT. OF PUBLIC WORKS
SEWER DIVISION

DATE

NO.


The undersigned applies for the construction of a particular sewer connecting No.
Street and hereby agrees to comply with the Rules and Regulations governing the construction and use of Particular
Sewers, as now or at any future time established by the Board of Selectmen.

Am't of estimate \$

Am't Paid \$

..... Owner

Sketch of Service Here

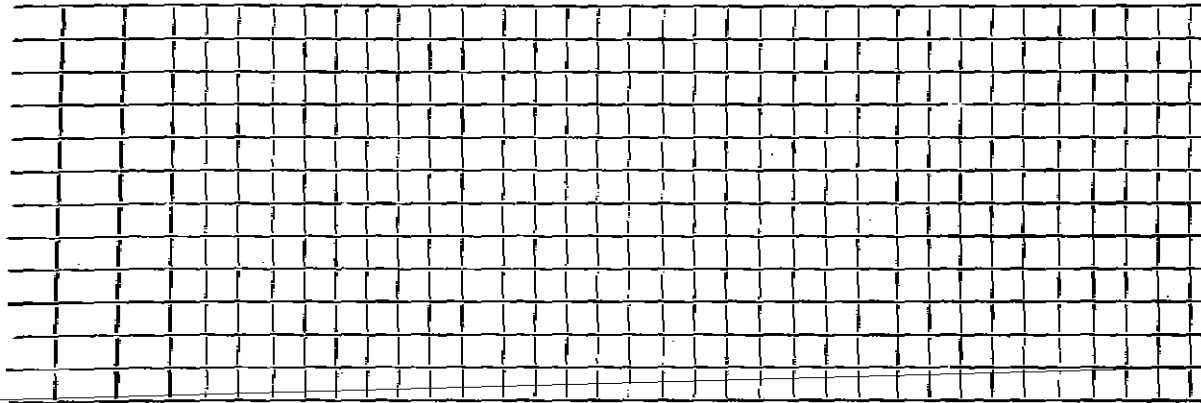

Connection made in Street.

Work completed 19..

Remarks: