

Name C.B. Westgate & Son

Service No. 172

Address 29 Woodland Road

Location

Kind of Pipe Permit #137
Suburbanite Cesspool Co.

Size

Size of Main

~~Renewal~~ ~~New Service~~ W.O. #9311

Location

DEC 28 1964

Date	Material	Amount	Total	Date	Amount
10-23-64	Labor	56 05		10-26-64	175 00
	10% O.H.	5 61	61 66	12-28-64	99 08
36	6" Transite pipe @.82		29 52		75 92
1	90° Elbow		4 09		
1	6X8 Saddle		5 25		
1	Duplex Adapter		2 06		
1	End Cap		1 93		
26	X 3 Patch		26 00		
1	Hr. Town Shovel @6.50		6 50		
1	Hr. Tractor		6 00		
1	Hr. Trucking		3 00		
			146 01		
	PRO-RATE				
	146.01 X 13/25 yrs. =	75.92			
11-12-64	10 6" Transite Pipe				

Deposit
Retard


13
57
6

DATE _____

TOWN OF LEXINGTON — BOARD OF PUBLIC WORKS

SEWER DIVISION

Sketch of Service Here

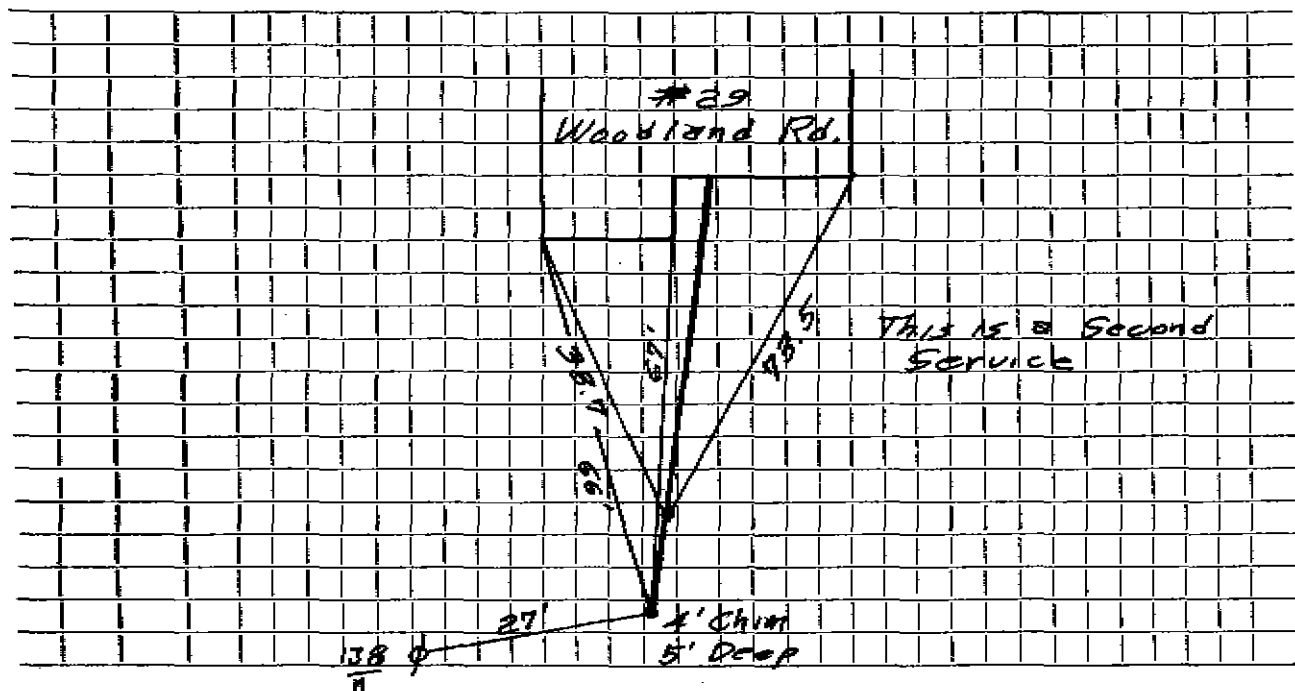

Connection made in Street. Work completed

Remarks:
.....
.....

