

Service to curb - to be charged when connected

Name **Frank Cross**

Service No. **14**

Address **31 Woodland Road**
Lexington, Mass.

Location

Kind of Pipe

Size

Size of Main

~~Repair/Replace~~ **New Service** **WOFF 7819**

Location **Comm 5-27-63**

Date	Material	Amount	Total	Date	Amount
Aug. 1951	Flat Rate		72 00	4-4-63	300 00
	INSTALLED BY CONTRACTOR			5-27-63	57 96
					246 04
4/8/63	24' - 6" sewer pipe @ .342	8.21			
	Labor	100 59			
	10% O.H.	10 06	110 65		
	40' 6" Transite Pipe @ .82		32 80		
	1 1 1/2" Transite Bend		4 09		Problem appears to be in main
	3 Hrs. Town Shovel @ 6.50		19 50		
	2 Hrs. Trucking @ 3.00		6 00		
	1 Hr. Pumping @ 1.00		1 00		
			<u>246 04</u>		
	Labor				

TOWN OF LEXINGTON—DEPT. OF PUBLIC WORKS

SEWER DIVISION

DATE

NO.


The undersigned applies for the construction of a particular sewer connecting No. Street and hereby agrees to comply with the Rules and Regulations governing the construction and use of Particular Sewers, as now or at any future time established by the Board of Selectmen.

Am't of estimate \$

Am't Paid \$

..... Owner

Sketch of Service Here

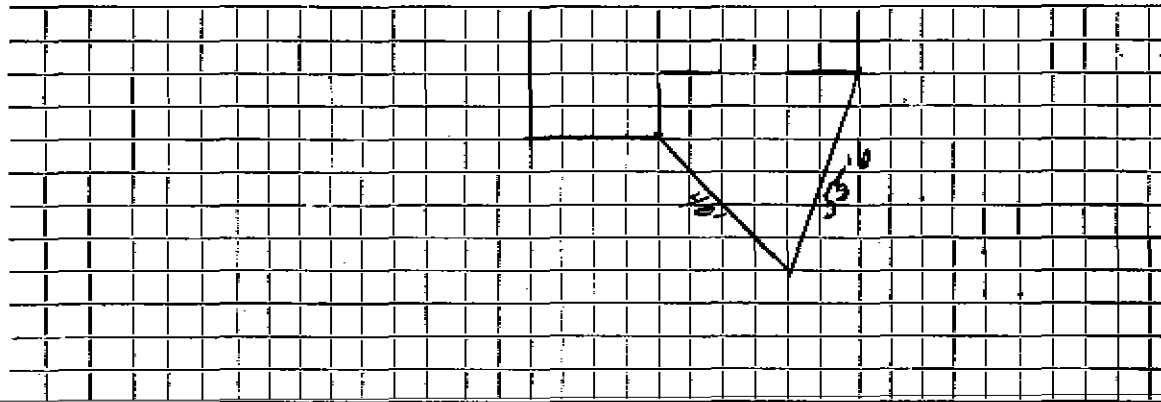

$$\begin{array}{r} 96 \\ 67 \\ \hline 29 \end{array}$$

Connection made in Street.

Work completed 19..

Remarks: