

Name Anthony J. Raciti

Service No. 42

Address 34 Woodcliffe Road

Location

Kind of Pipe John E. Grant Permit #A238

Size

Size of Main

~~REPAIR~~ New Service

PERMIT 0916 - KIRKLAND & SHAW (12/2/96)

Location


MAY 2 1966

Date		Material	Amount	Total	Date		Amount
2-9-65	14'	6" Transite pipe @5.00		70.00	4-15-66	Deposit	20 00
4-18-66	46'	6" Transite pipe					
2/9		1-2.5					
						Repair W.O. #1368	
					9-4-80	Labor	
						1 6" x 6" Transite Nipple	
						1 6" x 11 1/2" Elbow	
						1 6" x 22 1/2" Bend	
						1 6" Fernco Cply	
						1 hr. Trucking	
						1/2 hr. Town Shovel	

SEWER REPAIR OVER GAS PIPE 9-4-30
BROKEN BY GAS CO.

Remarks:

Connection made in

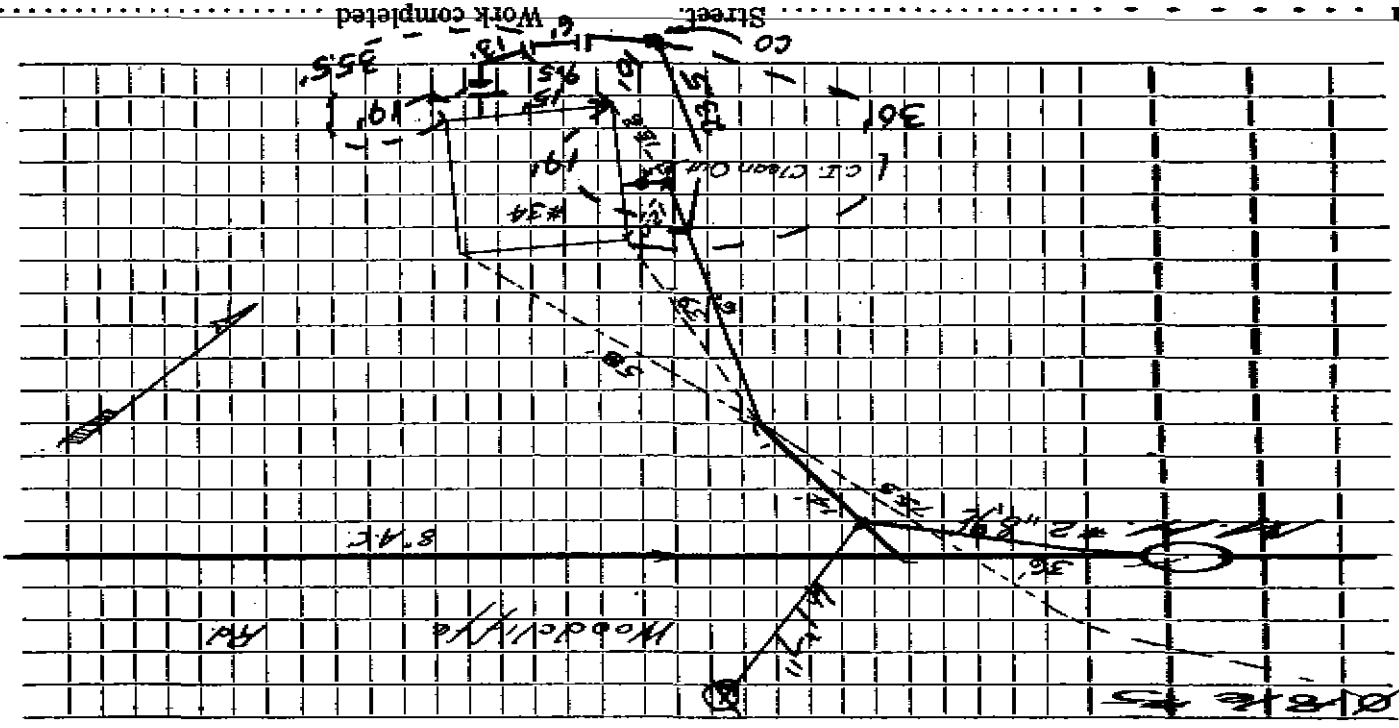

Sketch of Service Here

SEWER DIVISION

TOWN OF LEXINGTON — BOARD OF PUBLIC WORKS

DATE UPDATED 2/19/97