

Name Wellington Ross

Service No. 126

Address 35 Woodland Road

Location

Kind of Pipe

Size

Size of Main

~~REPAIR WORK~~ New Service

Com. 9-20-54

Location

Date	Material	Amount	Total	Date	Amount
8/30/54	Labor	32 12		8-10-54 Deposited	175 00
	10% overhead	3 21	35 33	9-20-54 Refunded	116 14
	48' - 6" sewer pipe @ .30		14 40		158 86
	joint compound		2 88		
	3 2/3 hrs. Littlefield shovel @ 7.50		27 50		
	1 hr. trucking		75		
			80 86		
	Plus attached card:		78 00		
			158 86		
	Labor				

Name John Bridgewater

Service No. 89

Address 36 Woodland Road

Lexington, Mass.

Location

Kind of Pipe

Size

Size of Main

~~EXISTING~~ New Service

COM. 10-22-51

Location

Date	Material	Amount	Total	Date	Amount
Aug. 1951	flat rate INSTALLED BY CONTRACTOR		165 00	8-6-51	165 -
	55' -6" sewer pipe @ .342	-\$22.91			
	1 - 6x6 tee	1.28			
4-19-79	65' 4" Cast Iron pipe (Renewal - Clearway #3375)			3-16-64	29 52
	Labor			3-75-83	S.B. Flat Pipe at M.H.

TOWN OF LEXINGTON—DEPT. OF PUBLIC WORKS
SEWER DIVISION

DATE

NO.


The undersigned applies for the construction of a particular sewer connecting No.
Street and hereby agrees to comply with the Rules and Regulations governing the construction and use of Particular
Sewers, as now or at any future time established by the Board of Selectmen.

Am't of estimate \$.....

Am't Paid \$.....

..... Owner

Sketch of Service Here

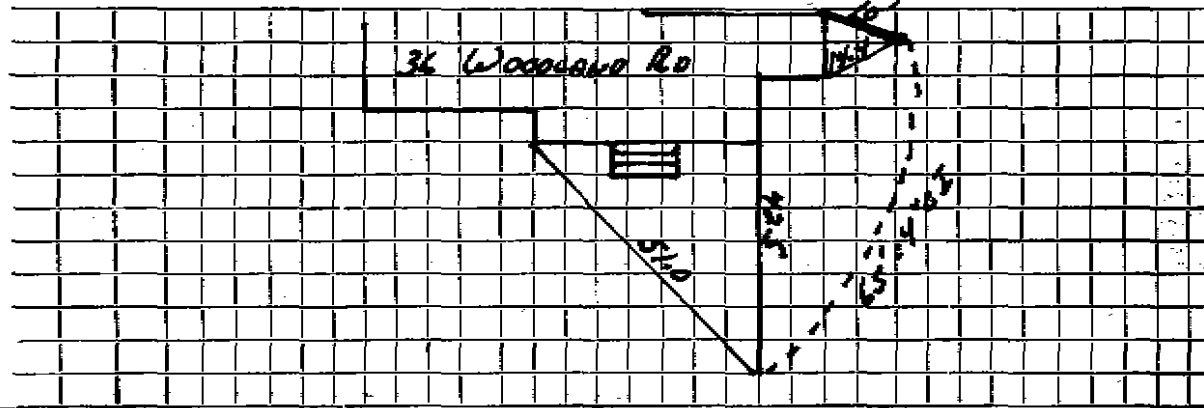

Connection made in Street.

Work completed 19..

Remarks:

