


TOWN OF LEXINGTON — BOARD OF PUBLIC WORKS
SEWER DIVISION

DATE 5/26/21

Sketch of Service Here

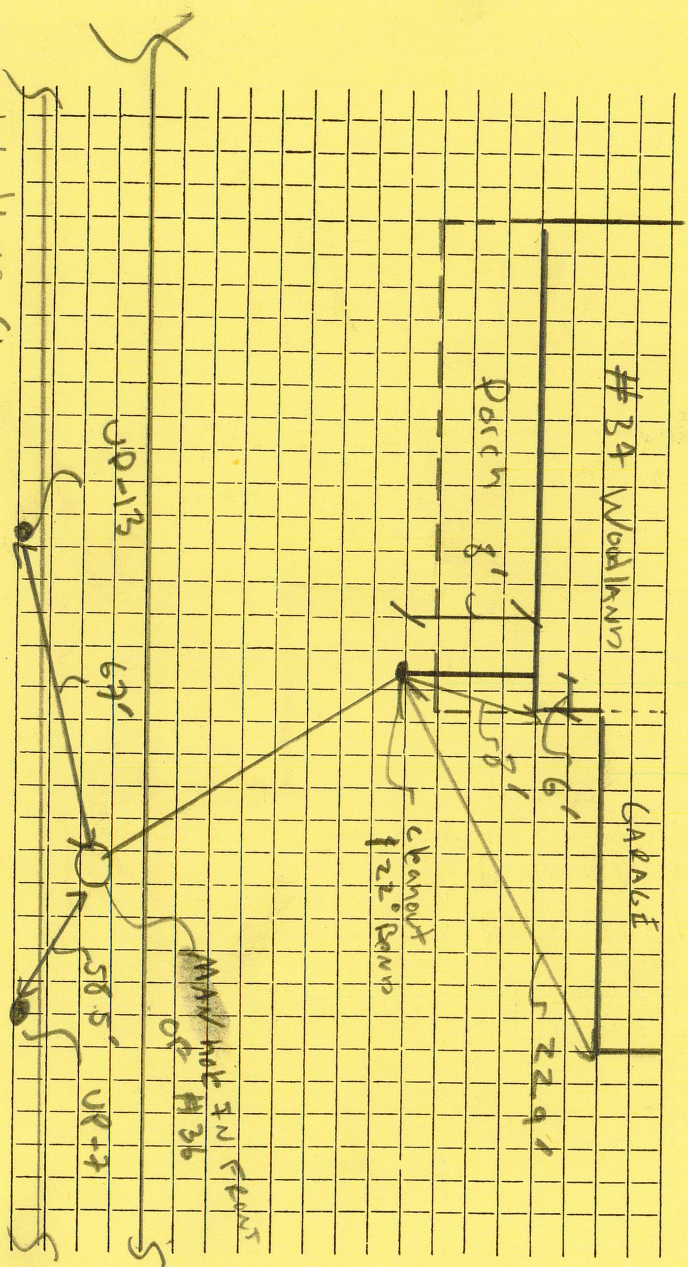

Connection made in Woodland St Street Work completed

Remarks: connected into existing. M.H. in street 1/4 No. Town Line in front of house & Manhole no. 36 SW of line.

Name SADCO Development

Service No. WW-218

Address #37 Woodland

Location

Kind of Pipe SDR-35 6'

Size 6"

Size of Main N/A

~~Repair~~ Renewal New Service

Location

Date	Material	Amount	Total	Date	Amount
5/24/21	POPS → HOUSE				
	M.H → SDR-35 (6") (Hyd current repairs)	N/A			
	22° 6" Bend	①			
	Clearcut (WE)	①			
	4" PVC Pipe	26'			

Name Earl Outhet

Service No. 187

Address 37 Woodland Road

Location

Kind of Pipe

Size

Size of Main

~~Repair~~ ~~Renovate~~ New Service

Location Comm 5-459

Date	Material	Amount	Total	Date	Amount
3-23-59	Labor	65 30		12-24-58	150 00
3-24-59	"	53 16		5-4-59	12 14
		118 46		5-18-59	153 27
	10% O.H.	11 85	130 31		365 41
	90' 6" Transite Pipe @.70		63 00		
	1 11 1/2" Transite Bend		5 10		
	8 Hrs. Town Shovel @6.50		52 00		
	2 Hrs. Trucking @.75		1 50		
	6 Hrs. Compressor @3.00		18 00		
	3 Hrs. Insley @6.50		19 50		
	1 Hr. Rodgers Trailer @3.00		3 00		
	1 Hr. Trucking @3.00		3 00		
	Labor				
	20 x 3 Patch		20 00		
			315 41		
				Bill sent 5-4-59	153.27

TOWN OF LEXINGTON—DEPT. OF PUBLIC WORKS
SEWER DIVISION

DATE.....

NO.


The undersigned applies for the construction of a particular sewer connecting No.....
Street and hereby agrees to comply with the Rules and Regulations governing the construction and use of Particular
Sewers, as now or at any future time established by the Board of Selectmen.

Am't of estimate \$.....

Am't Paid \$.....

..... Owner

Sketch of Service Here

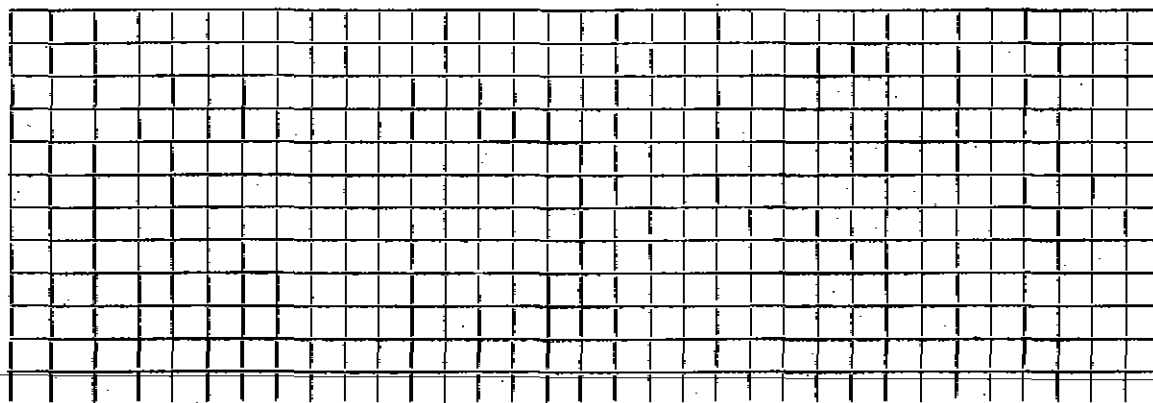

Connection made in Street.

Work completed.....19..

Remarks: