

Name Donald C. Brewster

Service No. 82

Address #40 WOODLAND RD.

Location

Kind of Pipe

Size

Size of Main

Repair—Renewal—New Service

W.O. # 8058

Location


Camrose-28-63

Date	Material	Amount	Total	Date	Amount
7-16-63	Labor 104.01			7-8-63	Deposit 400.00
	" 56.01	160 02		10-28-63	Refund 31.68
	10% O.H.	16 00	176 02		REPAIR W.O.#1062 368.32
100	6" Transite pipe @.82		82 00	12/21/84	1 Ft 6" PVC Pipe
1	11 $\frac{1}{4}$ " Transite bend		4 09	1	6"x8" AC saddle
1	6" Duplex Adapter		1 62	1	6" AC to 6" PVC adapter
1	90° Transite Elbow		4 09	1	6" PVC 90° elbow
5	Hrs. Town Shovel @6.50		32 50	1	6" PVC to 6" AC Fernco
2	Hrs. Trucking @3.00		6 00	6	yards gravel
32	X3 Patch		32 00	2	ton cold patch
10	Yards Loam@3.00		30 00		
			368 32		
				12-21-84	Broken pipe on road 128' out at elbow in main

DATE _____

TOWN OF LEXINGTON — BOARD OF PUBLIC WORKS
SEWER DIVISION

Sketch of Service Here

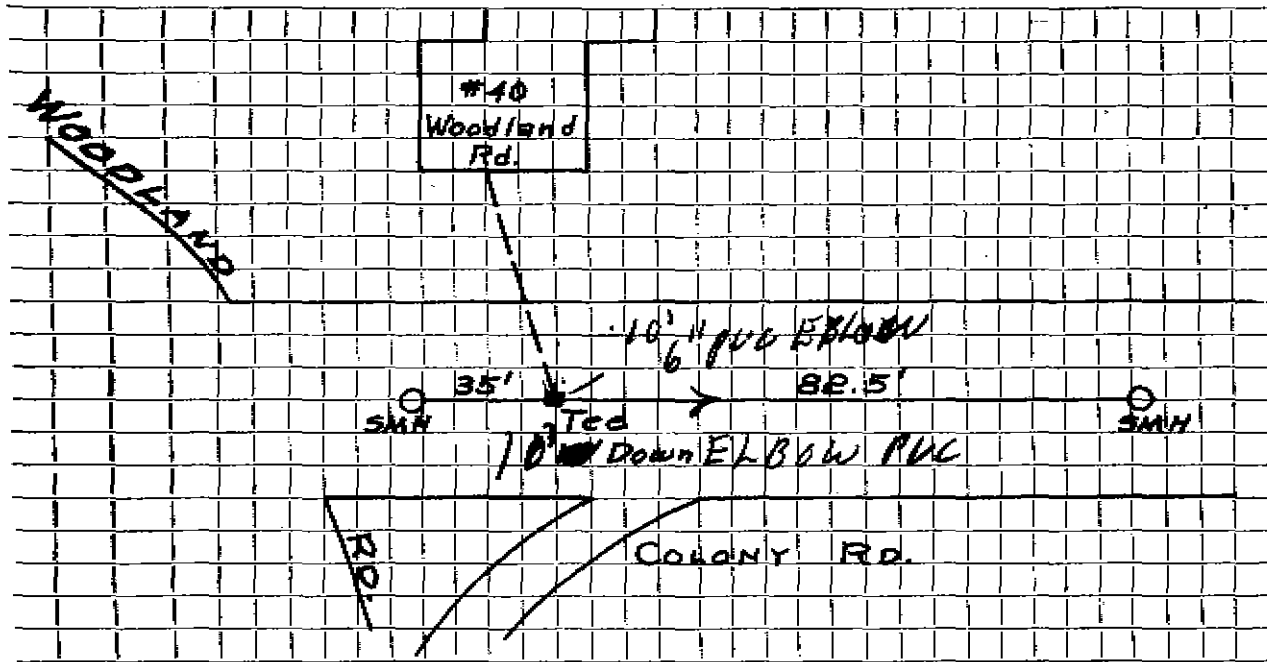

Connection made in Street. Work completed

Remarks:
.....
.....