




TOWN OF LEXINGTON — BOARD OF PUBLIC WORKS

SEWER DIVISION

Sketch of Service Here

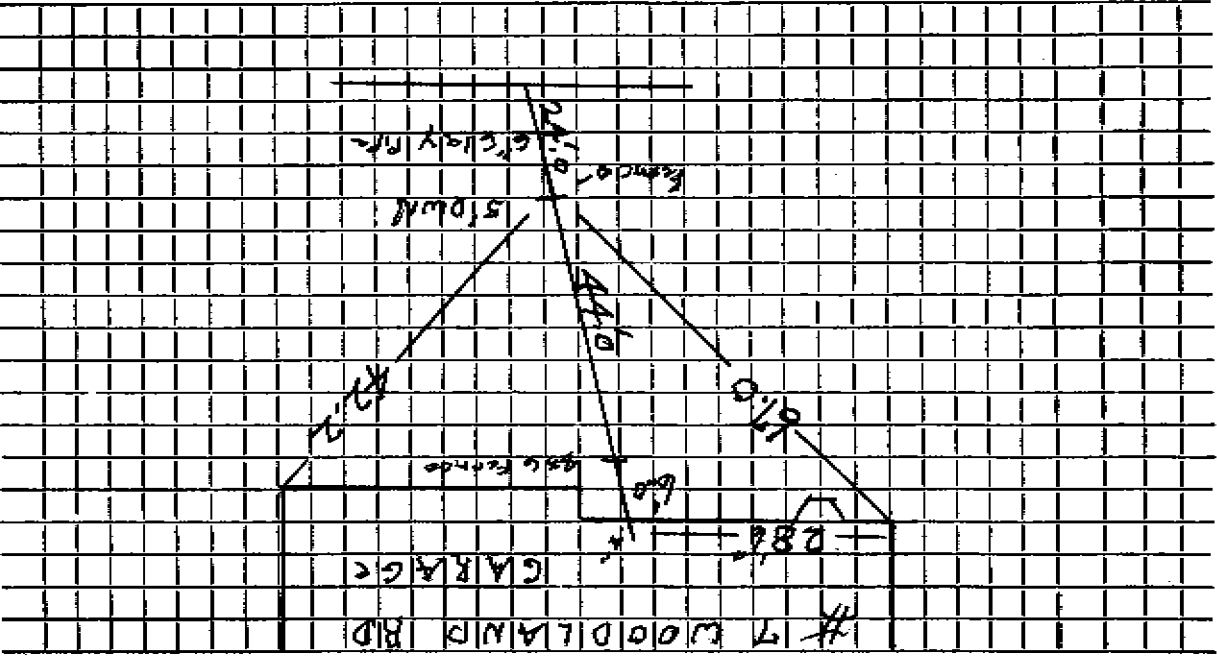

Connection made in

Street.

Work completed

6/3/07 J. Kel.

Remarks:

DATE