


TOWN OF LEXINGTON — BOARD OF PUBLIC WORKS
DATE _____

SEWER DIVISION

Sketch of Service Here

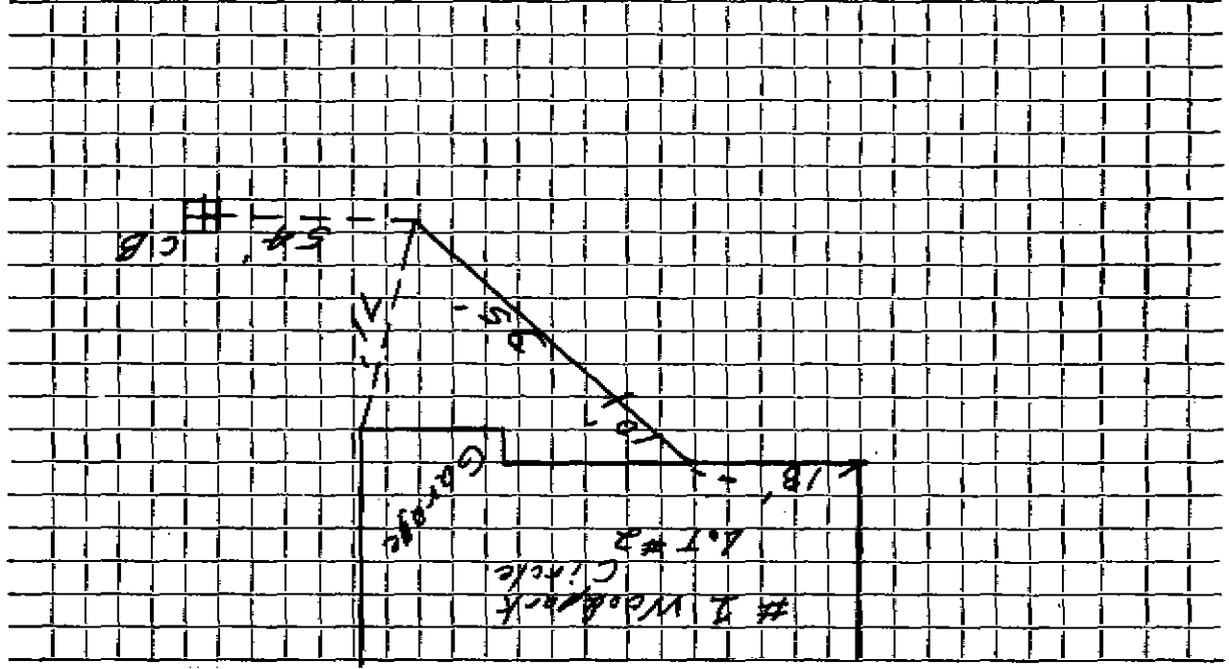

Connection made in Woodpark Circle Street. Work completed

Remarks: