

Name

Service No.

Address *10 Wood Park Circle*

Kind of Pipe

Size

Size of Main

Location

Repair—Renewal—New Service


Location

Date	Material	Amount	Total	Date	Amount
<i>9/8</i>	<i>75' - 6" R.C.P.</i>				
	<i>7' - 9" T.V.C.</i>				
	<i>CONNECTED BY CONTRACTOR</i>				

DATE \_\_\_\_\_

**TOWN OF LEXINGTON — BOARD OF PUBLIC WORKS**  
**SEWER DIVISION**

Sketch of Service Here

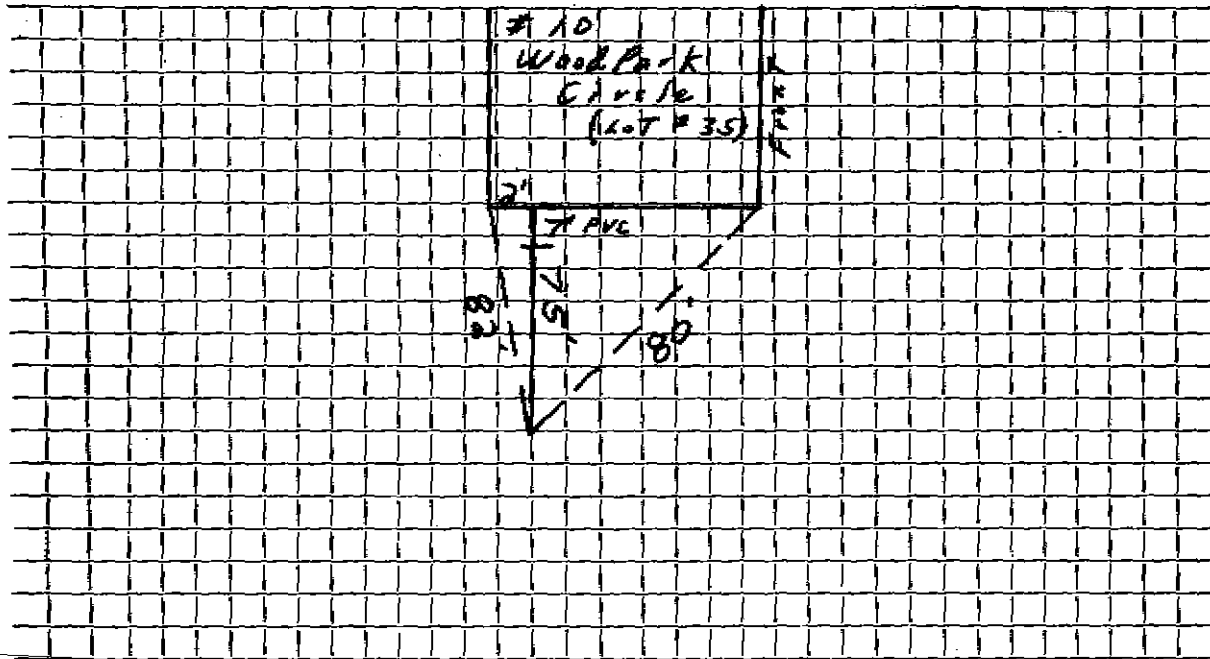

Connection made in ..... Street. Work completed .....

Remarks: .....  
.....  
.....