

Name

Service No.

Address #11 WOODPARK CIRCLE

Location

Kind of Pipe

AC

Size 6"

Size of Main

Repair—Removal—New Service


Location

Date	Material	Amount	Total	Date	Amount
4/12/77	68' - 6" AP				
	10' - 4" PVC				
	CONNECTED BY CONTRACTOR				

TOWN OF LEXINGTON — BOARD OF PUBLIC WORKS

SEWER DIVISION

Sketch of Service Here

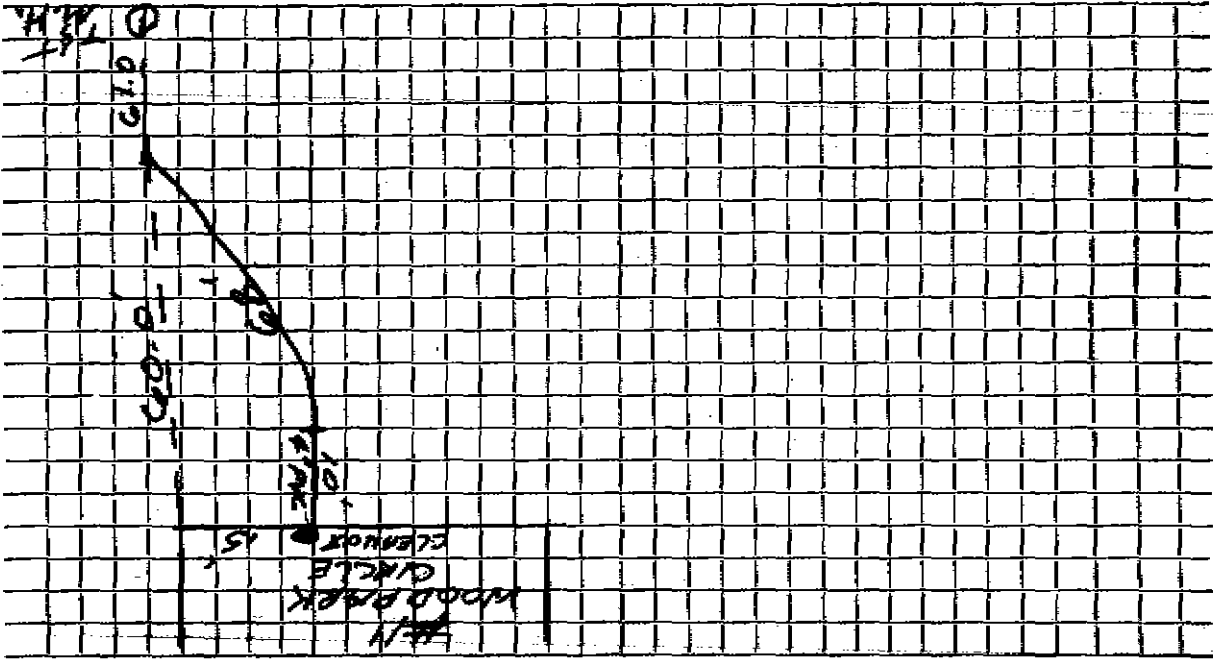

Connection made in WOOD PARK CIRCLE Street. Work completed

Remarks:

DATE