

Name

Service No.

Address *19 Woodpark Circle*

Location

Kind of Pipe

Size

Size of Main


Repair—Renewal—New Service

Location

Date	Material	Amount	Total	Date	Amount
<i>8-10-77</i>	<i>188' = 6" A.C.F.</i>				
	<i>2' = 1" P.H.G.</i>				
	CONNECTED BY CONTRACTOR				

SEWER DIVISION

Sketch of Service Here

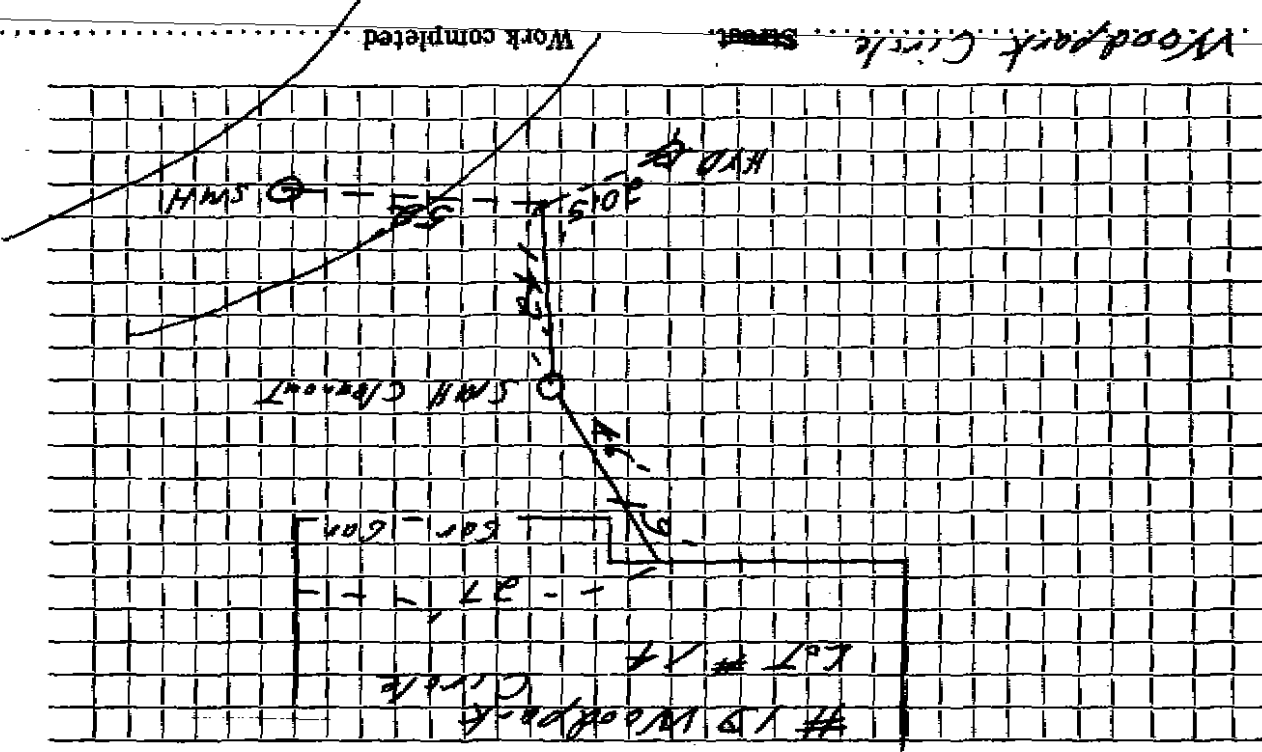

Connection made in Woodpark Circle Street

Remarks: