




DATE Dec, 2022

TOWN OF LEXINGTON — BOARD OF PUBLIC WORKS  
SEWER DIVISION

Sketch of Service Here  
20 Woodpark Circle

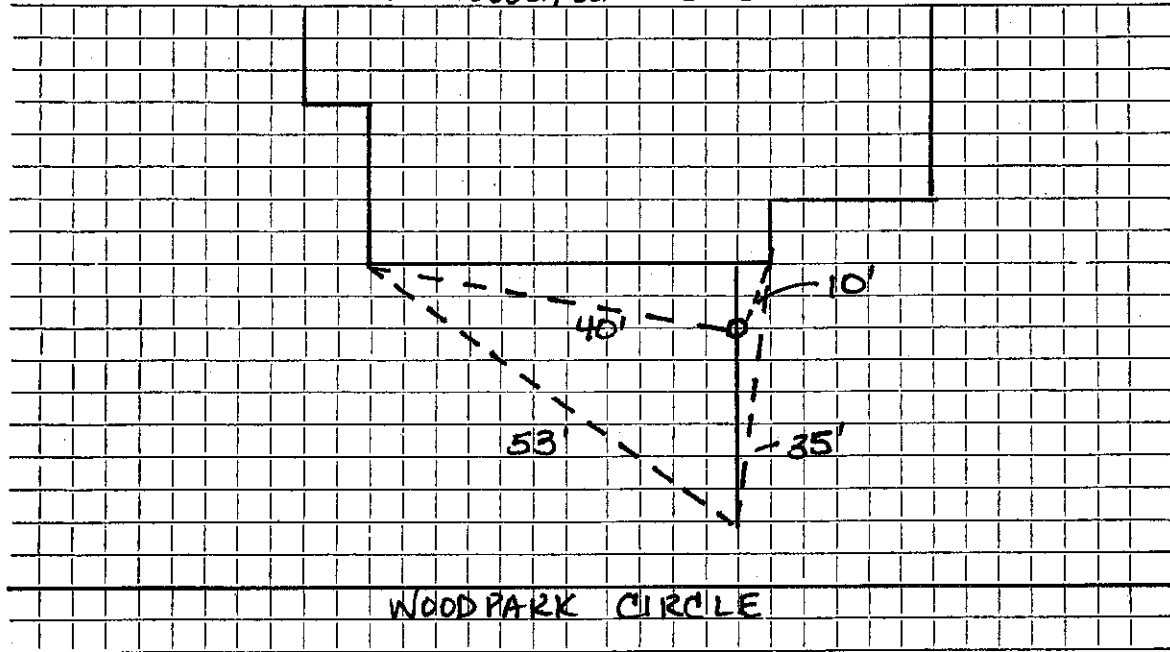

Connection made in ..... Street. Work completed .....

Remarks: Installed by Sadco