

Name

Service No.

Address 21 Wood Park Circle

Location

Kind of Pipe

Size

Size of Main

Repair—Renewal—New Service

Location


Date	Material	Amount	Total	Date	Amount
<u>8/22</u>	<u>76 65'-6" A.C.P.</u>				
	<u>10'-4" P.V.C.</u>				
	<u>CONNECTED BY CONTRACTOR</u>				

T-18-36-18-01

DATE _____

TOWN OF LEXINGTON — BOARD OF PUBLIC WORKS
SEWER DIVISION

Sketch of Service Here

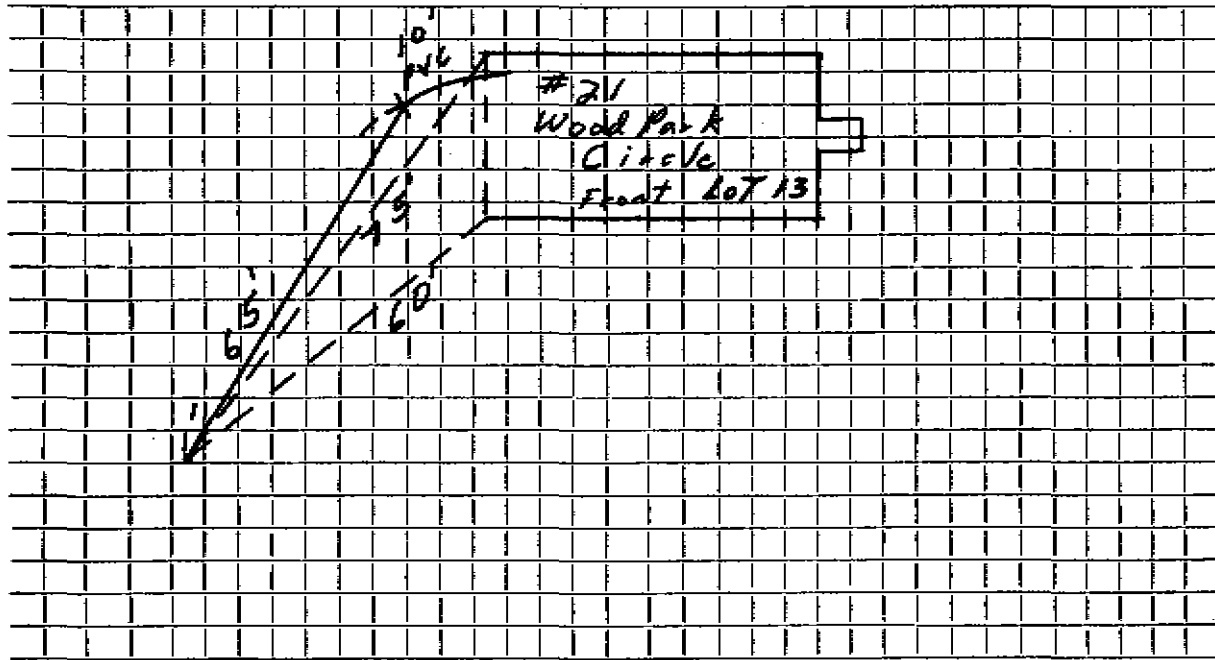

Connection made in Street. Work completed

Remarks:
.....
.....