

Name

Service No.

Address 22 Wood Park Circle

Location

Kind of Pipe

Size

Size of Main

Repair—Renewal—New Service

Location

Date	Material	Amount	Total	Date	Amount
2/16	76	30'-6" R.C.P.			
		10'-4" P.V.C.			
		CONNECTED BY CONTRACTOR			

TOWN OF LEXINGTON — BOARD OF PUBLIC WORKS

SEWER DIVISION


DATE \_\_\_\_\_

Sketch of Service Here

# 22 Wood Park

Circle

(Lot # 23)

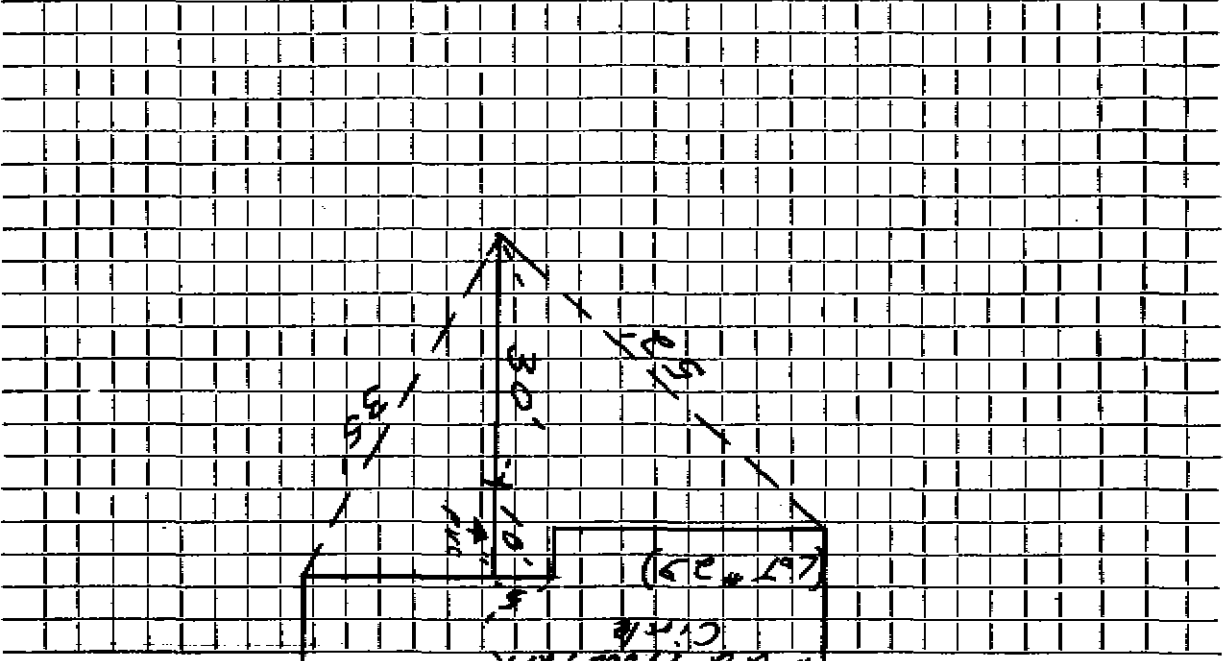

Connection made in .....

Street .....

Work completed .....

Remarks: .....