




TOWN OF LEXINGTON — BOARD OF PUBLIC WORKS  
DATE \_\_\_\_\_

SEWER DIVISION

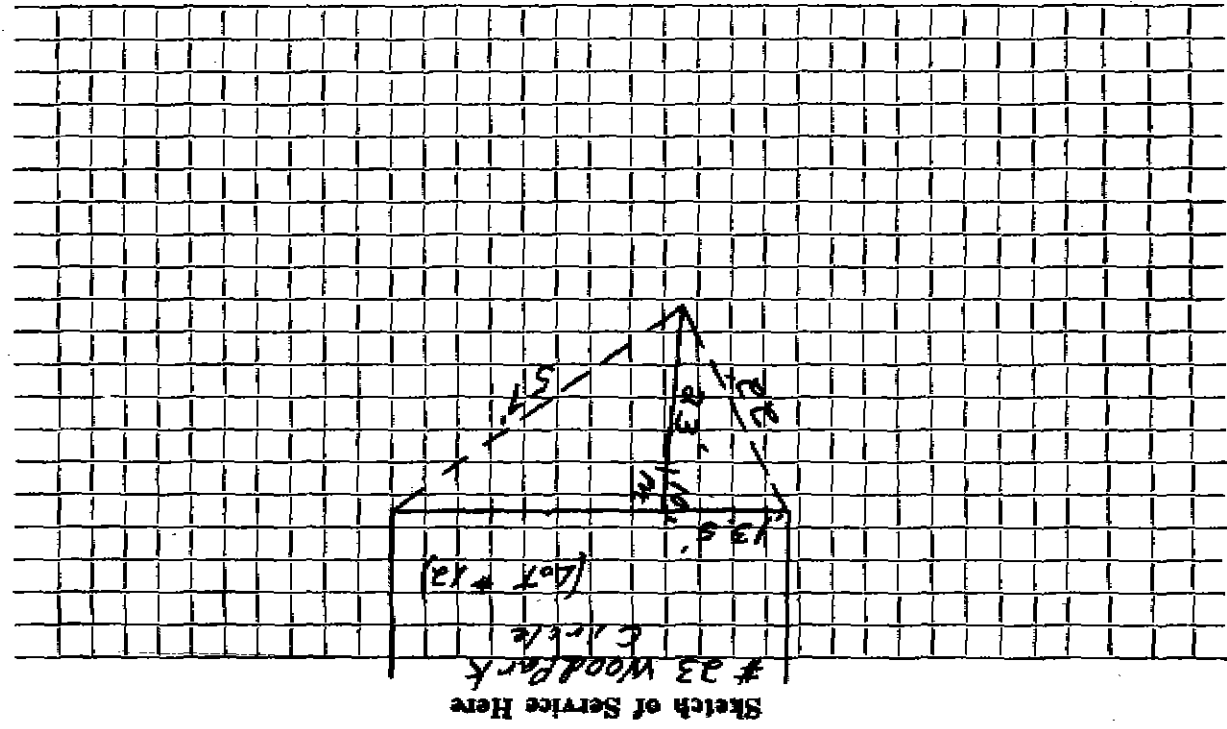

Connection made in .....

Street .....

Work completed .....

Remarks: .....