

Name

Service No.

Address #25 Wood Park Circle

Location

Kind of Pipe

Size

Size of Main

Repair—Renewal—New Service

Location


Date	Material	Amount	Total	Date	Amount
7/7	76 27' - 6" O.C.P.				
	10' - 4" P.V.C.				
	CONNECTED BY CONTRACTOR				

TOWN OF LEXINGTON — BOARD OF PUBLIC WORKS

SEWER DIVISION

DATE _____

Sketch of Service Here

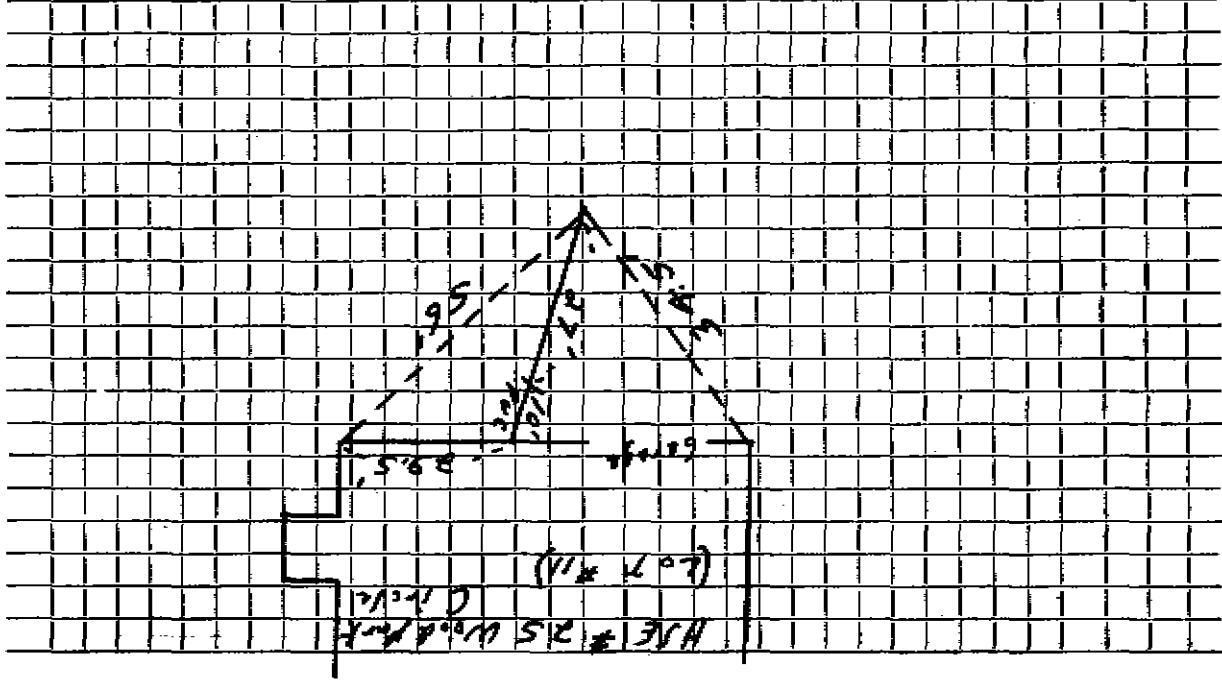

Work completed

Sheet

Wood Park Circle Street

Connection made in

Remarks: