


TOWN OF LEXINGTON — BOARD OF PUBLIC WORKS
 SEWER DIVISION
 DATE _____

Sketch of Service Here

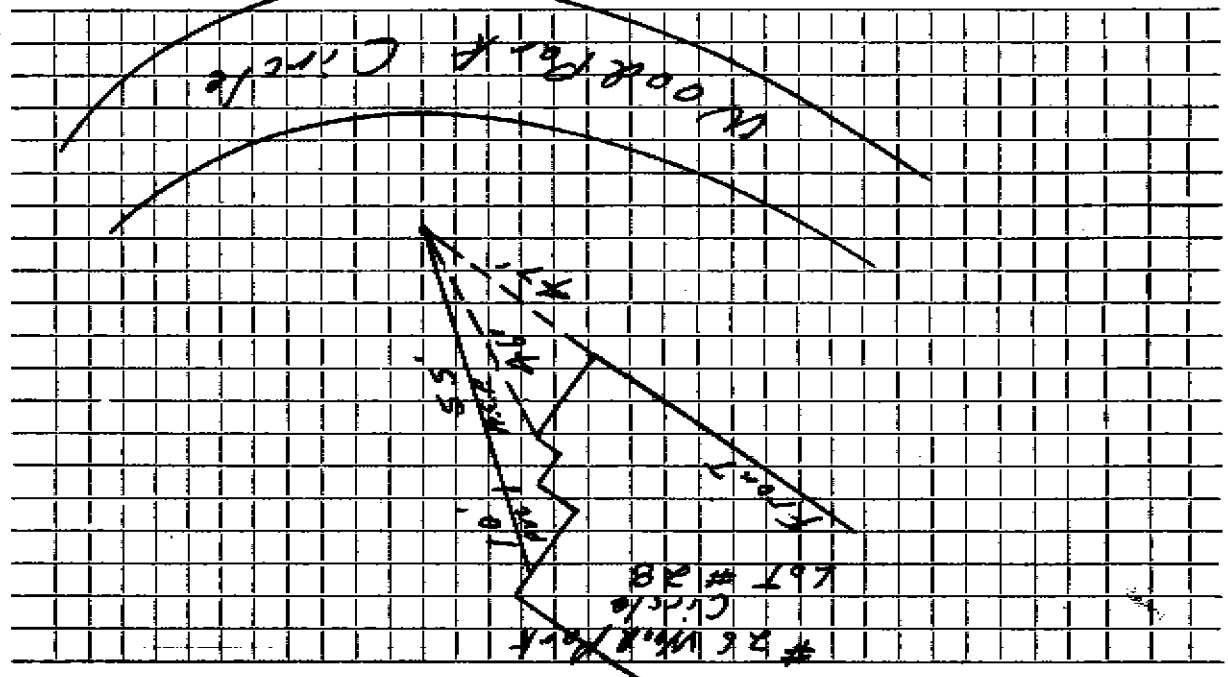

Connection made in _____

Street _____

Work completed _____

Remarks: _____

