

三

Service No.

Address 28 Woodback Circle

三

卷之三

Repair—Reassembly—Service

1

Size of Main

Location

Amount

104

卷之三

三

三


四

3-1 77 20' = 6 D.C.P.
10' = 1 " MVC

CONTRACT BY CONTRACTOR

Remarks:

Connection made in wood perch larch steel. Work completed.

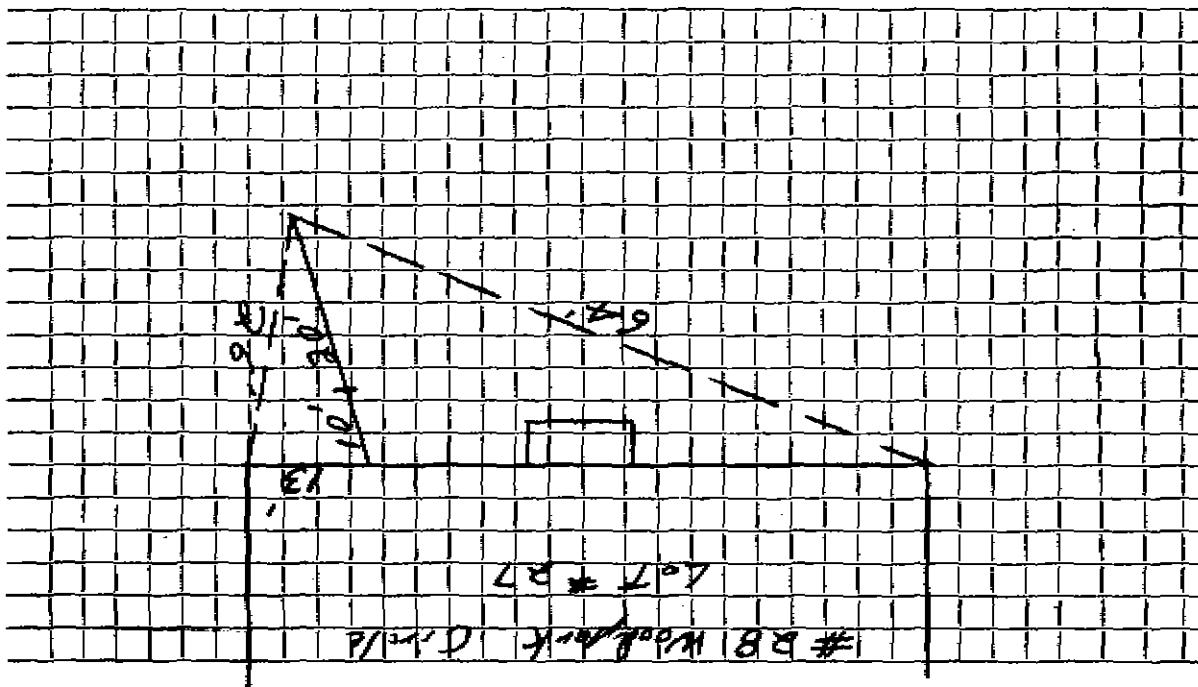

Sketch of Service Here

SEWER DIVISION

TOWN OF LEXINGTON — BOARD OF PUBLIC WORKS

DATE