

Name

Service No.

Address # 3 Woodpark Circle

Location

Kind of Pipe

Size

Size of Main

Repair—Renewal—New Service


Location

Date	Material	Amount	Total	Date	Amount
7/7	133'-6" A.C.P.				
	10'-9" PVC				
	CONNECTED BY CONTRACTOR				

DATE _____

TOWN OF LEXINGTON — BOARD OF PUBLIC WORKS
SEWER DIVISION

Sketch of Service Here

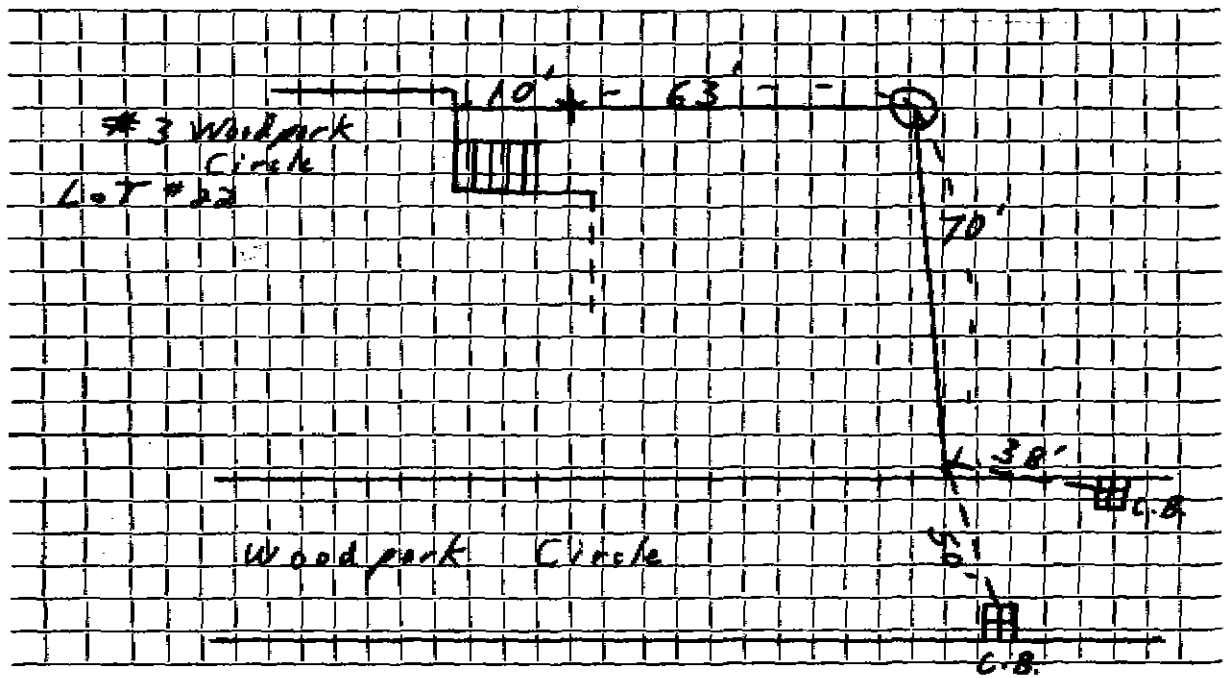

Connection made in Street. Work completed

Remarks:
.....
.....