

Name

Address 37 Woodpark Circle

Service No.

Location

Kind of Pipe Repair—Renewal—New Service

Size

Location

Size of Main

Amount

Date

Material

Amount

Total

Date


Amount

$$6 \cdot 34 \cdot 76 \quad 64' \cdot 6 = 6 \text{ " per } \\ 10' = 4 \text{ " per }$$

CONNECTED BY CONTRACTOR

Remarks:

Connection made in Woodlark Circle. Work completed.

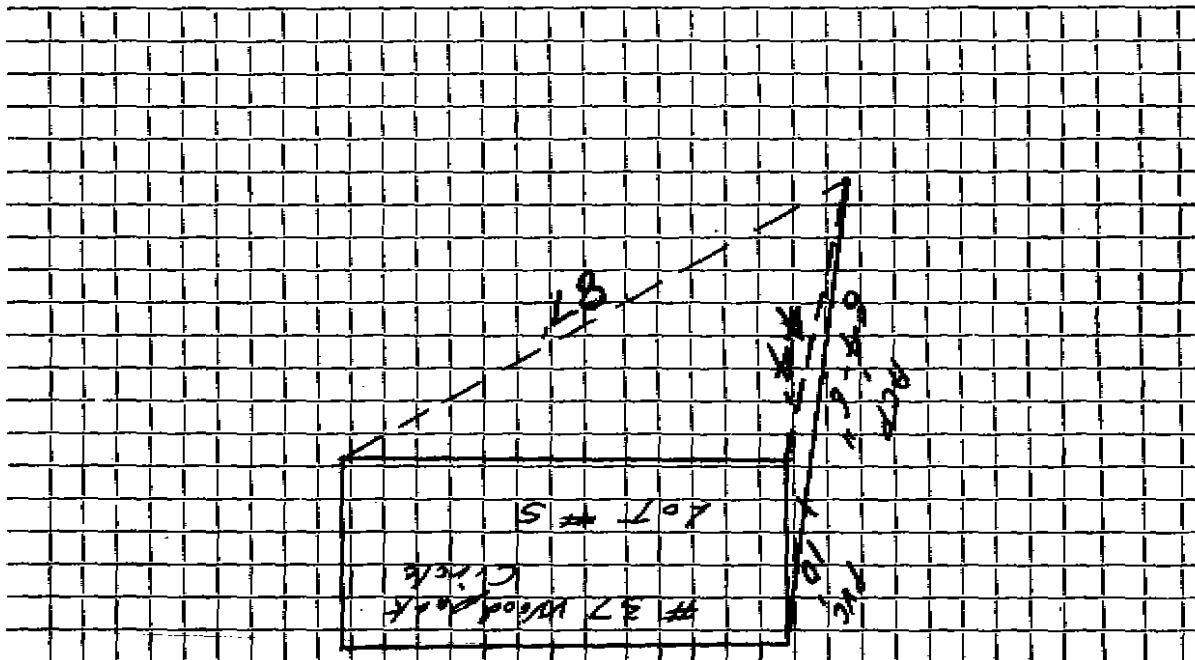

Sketch of Service Here

## SEWER DIVISION

TOWN OF LEXINGTON — BOARD OF PUBLIC WORKS

DATE