

Name

Service No.

Address *39 Woodpark Circle*

Location

Kind of Pipe

Size

Size of Main

Repair—Renewal—New Service

Location


Date	Material	Amount	Total	Date	Amount
<i>6/29</i>	<i>76 80' - 6" A.C.P.</i>				
	<i>10' - 9" P.V.C.</i>				
	<i>CONNECTED BY CONTRACTOR</i>				

DATE \_\_\_\_\_

TOWN OF LEXINGTON — BOARD OF PUBLIC WORKS

SEWER DIVISION

Sketch of Service Here

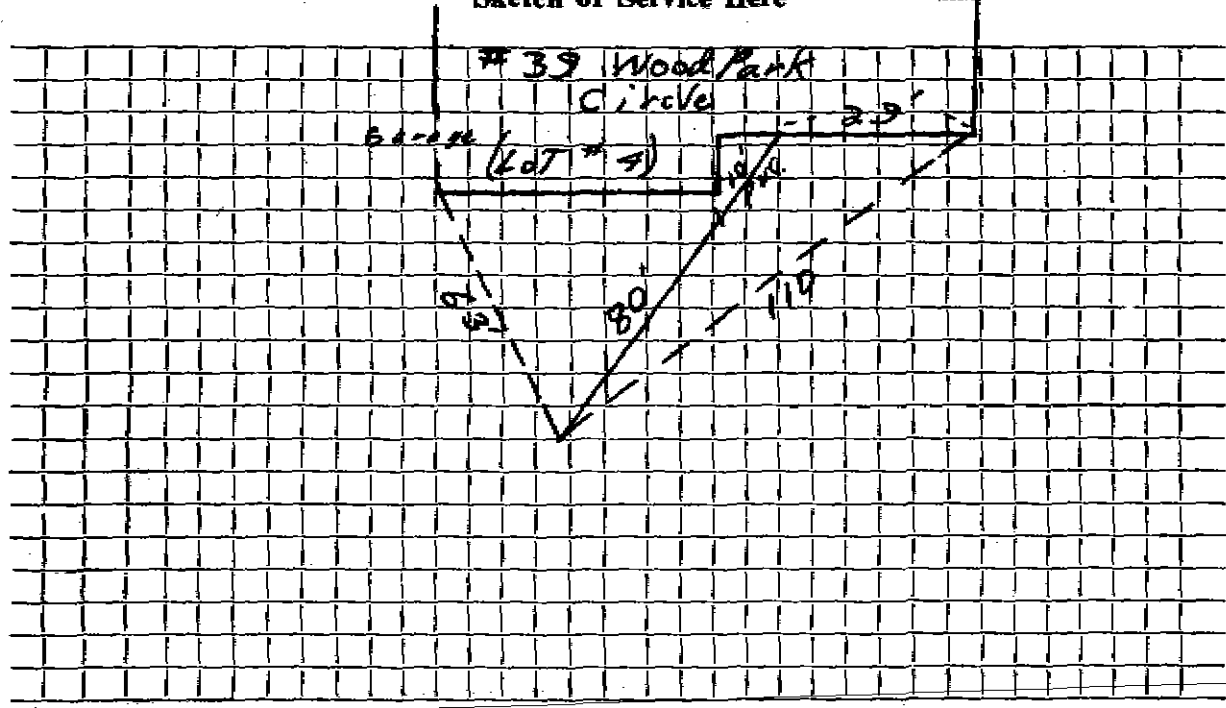

Connection made in ..... Street. Work completed .....

Remarks: .....  
.....  
.....