




SEWER DIVISION

Sketch of Service Here

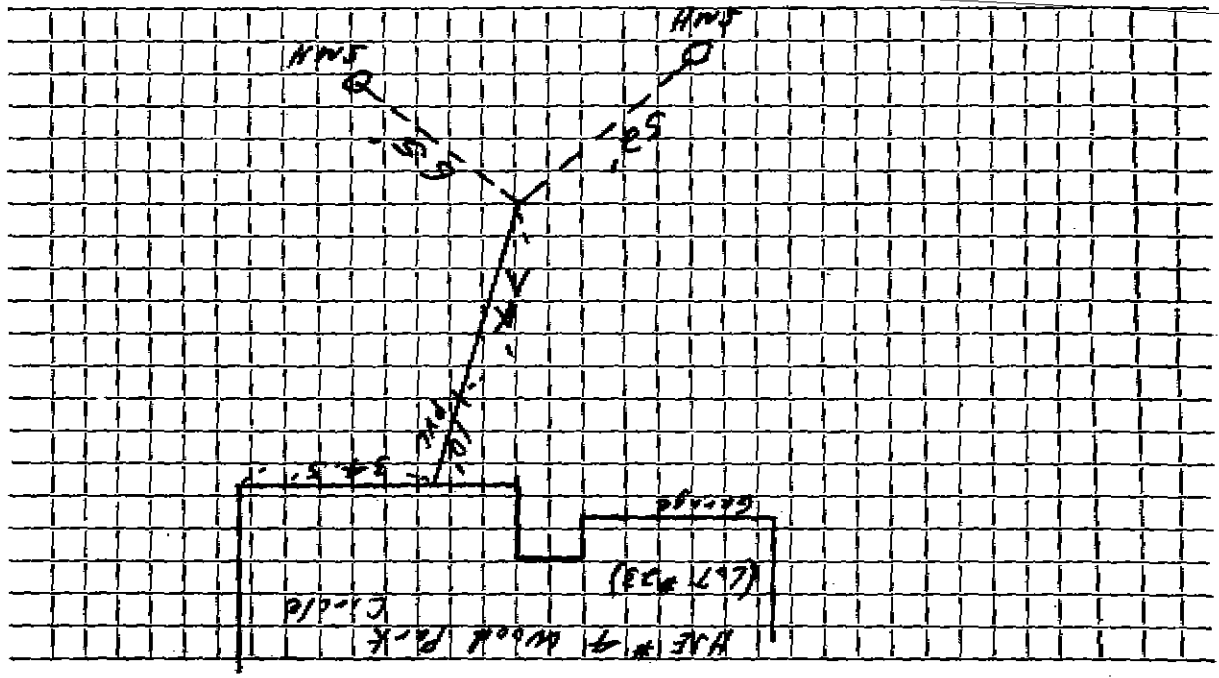

Work completed

Street

Connection made in Wood Park Circle

Remarks: