

Name

Service No.

Address *5 Woodpark Circle*

Location

Kind of Pipe

Size

Size of Main

Repair—Renewal—New Service

Location


Date	Material	Amount	Total	Date	Amount
<i>4/6</i>	<i>80' - 6" A.C.P.</i>				
	<i>10' - 4" B.V.C.</i>				
	CONNECTED BY CONTRACTOR				

TOWN OF LEXINGTON — BOARD OF PUBLIC WORKS

SEWER DIVISION

DATE _____

Sketch of Service Here

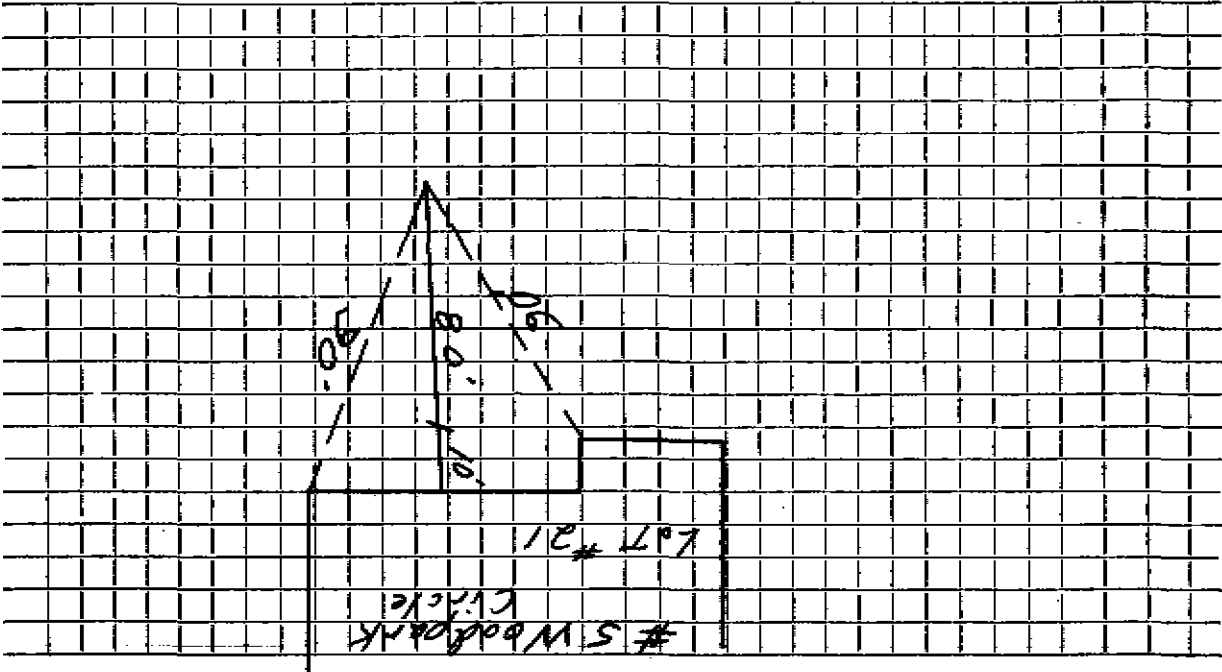

Work completed

Street

Connection made in

Remarks: