

Name

Service No.

Address # 9 Woodlark Circle (lot # 19)

Location

Kind of Pipe A.C Size 6"

Repair—Reinstall New Service at base of 25 ft


Date	Material	Amount	Total	Date	Amount
4-12-77	50' of 6" P.C.				
	10' of 4" P.C.				

CONNECTED BY CONTRACTOR

Remarks:

Connection made in 11000. PARK CIRCLE Street

Work completed

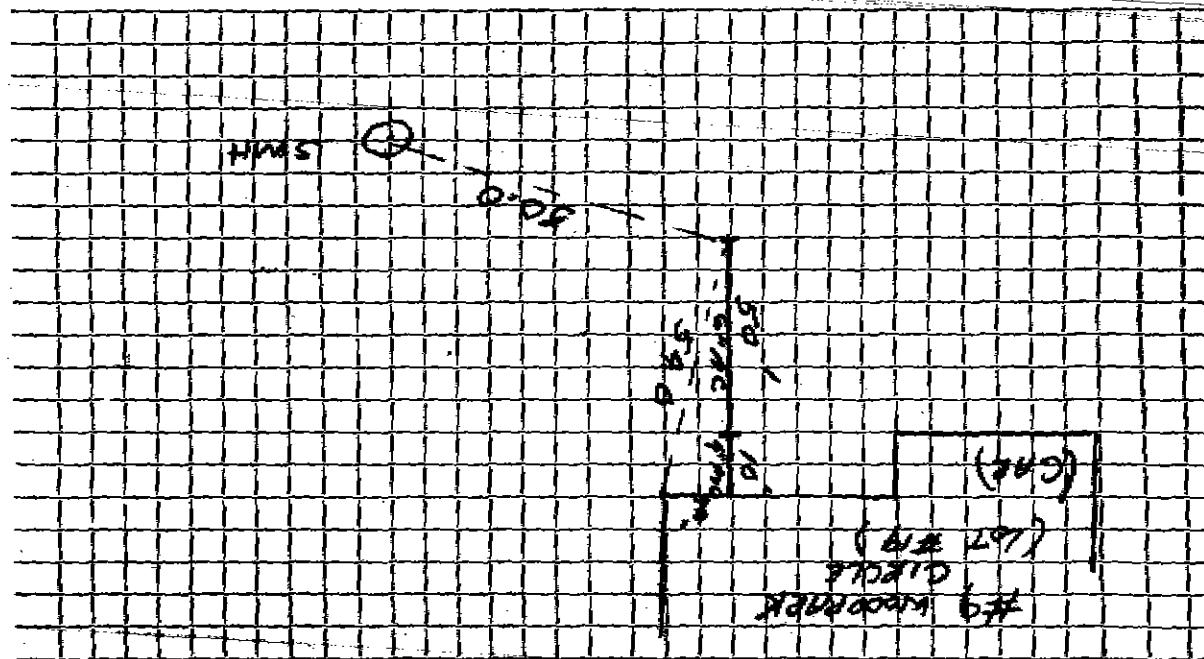

Select or Service Here

SEWER DIVISION

TOWN OF LEXINGTON — BOARD OF PUBLIC WORKS

DATE