




DATE 8/3/12

TOWN OF LEXINGTON — BOARD OF PUBLIC WORKS

SEWER DIVISION

118 Worthen

Sketch of Service Here

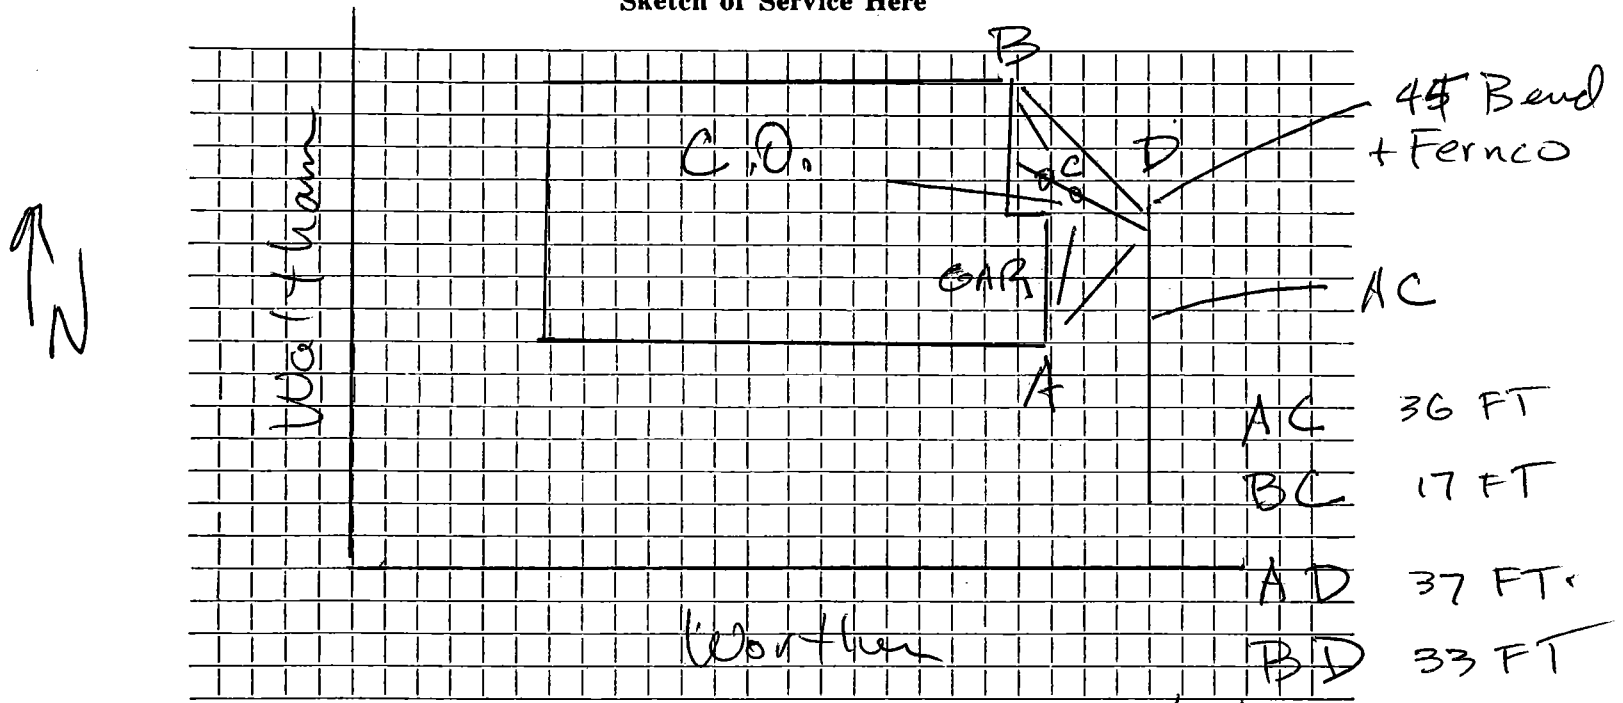

- AC 36 FT
- BC 17 FT
- AD 37 FT
- BD 33 FT

Connection made in Worther Street. Work completed 8/3/12

Remarks: 6' + COVER  
MFiamaney