

Name R. J. Foley

Service No.

Address 128 Worthen Rd.

Location

Kind of Pipe

Size

Size of Main

Repair—Renewal—New Service

DeFelice Bros. #1487


Location

Date		Material	Amount	Total	Date		Amount
10-27-69	40'	6" Transite pipe					
	10'	4" Cast Iron pipe			7-27	Solids in Main	

DATE \_\_\_\_\_

**TOWN OF LEXINGTON — BOARD OF PUBLIC WORKS**  
**SEWER DIVISION**

Sketch of Service Here

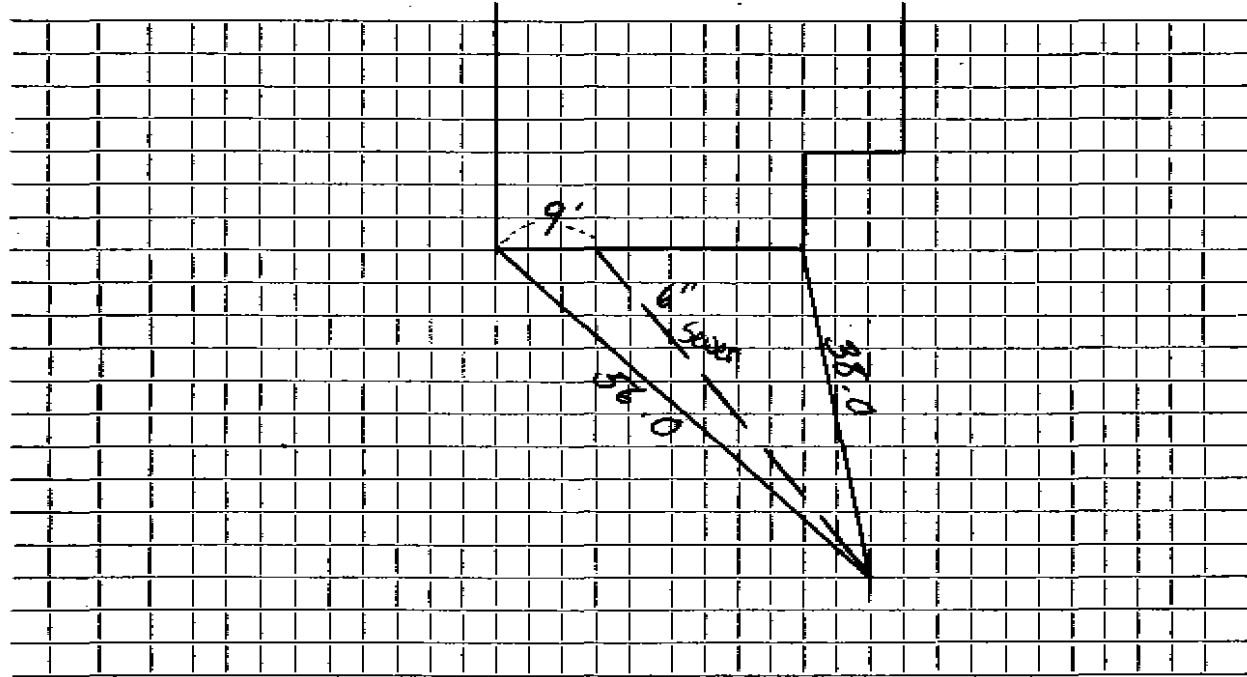

Connection made in ..... Street. Work completed .....

Remarks: .....  
.....  
.....