

Name

Service No.

Address 130 Worthen Road

Location

Kind of Pipe

Size

Size of Main

Repair—Renewal—New Service DeFelice Bros, #1171

Location


Date		Material	Amount	Total	Date	Amount
8/30/68	10'	4" Cast Iron				
	69'	6" Transite				

DATE _____

TOWN OF LEXINGTON — BOARD OF PUBLIC WORKS

SEWER DIVISION

Sketch of Service Here

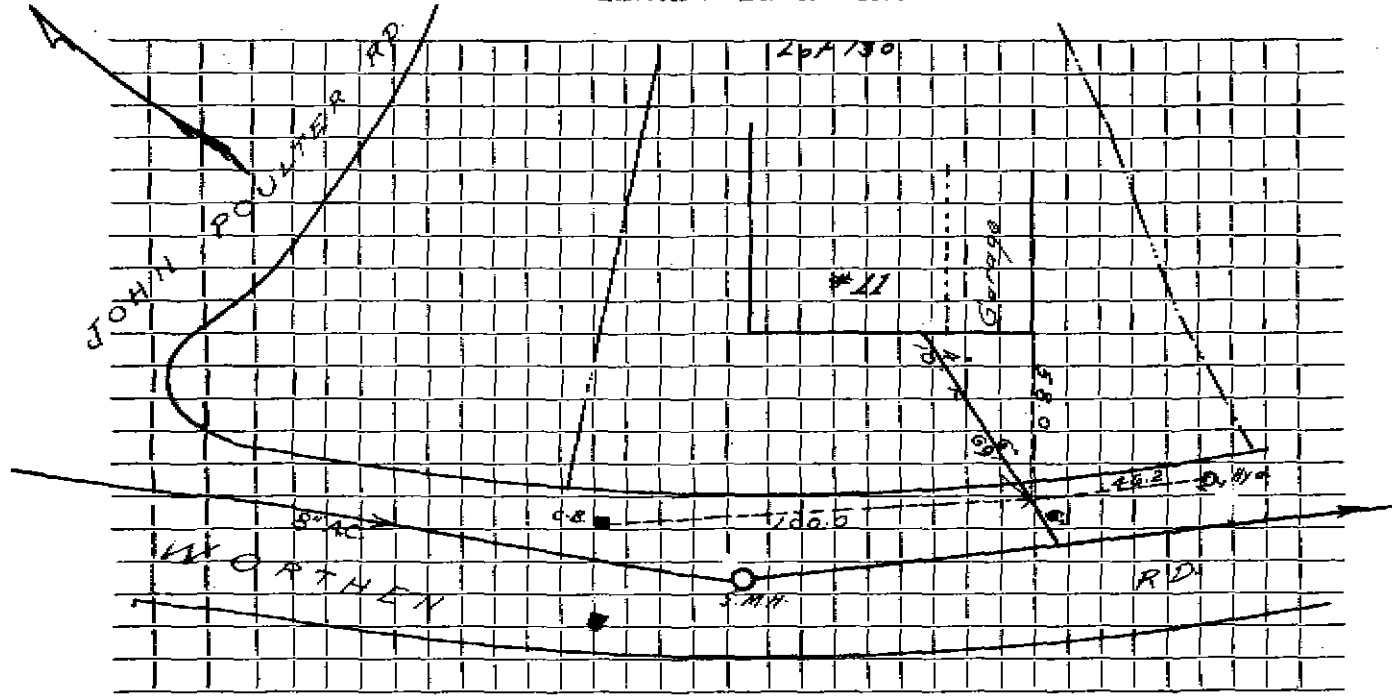

Connection made in _____ Street. Work completed _____

Remarks: _____

