

Name D & D Realty

Service No.

Address 131 Worthen Road

Location

Kind of Pipe

Size

Size of Main

~~Repair - Renewal~~ - New Service Valeri #3621

Location

Date	Material	Amount	Total	Date	Material	Amount
11-14-80	106' A. G. P. Pipe					
	2 10' x 6" ACP pipe					
	30' x 4" GIP					
	1 4" C.I. Wye					
	1 30° x 6" Bend			11-14-80	53' x 6" ACP	
	1 6" x 4" Donut				1 90° x 6" Elbow	
					Patch 2 Trenches	


OUTSIDE

TOWN OF LEXINGTON — BOARD OF PUBLIC WORKS

SEWER DIVISION

DATE _____

Sketch of Service Here

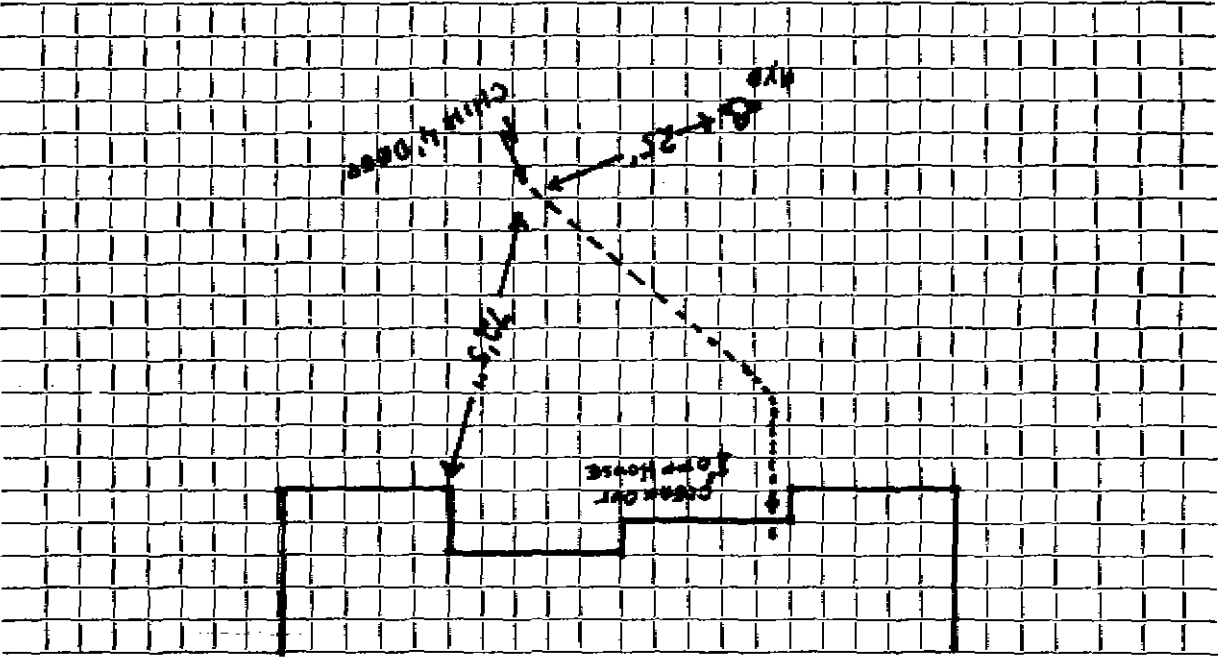

Connection made in _____ Street. Work completed _____

Remarks: _____