

Name Colonial Contractors & Builders, Inc.

Service No. 80

Address 132 Worthen Road

Location Lot 67

Kind of Pipe

Size

Size of Main

~~Repaired~~—New Service

Location *Cam 10-1-62*


Date	Material	Amount	Total	Date	Amount
8-22-60	Labor	13 08		6-12-62	Deposit
	10% O.H.	1 31	14 39	6-18-63	Paid
	20' 6" Transite pipe @70		14 00		125 12
	1 Hr. Trucking @3.00		3 00		
	<i>Bills when Connected</i>		31 39		
6-20-62	Labor	40.17			
	10% O.H.	4.02	44.19		
	41' 6" Transite pipe @.78		31.98		
	1 22 1/2° Transite Elbow		2.35		
	1 11 1/2° Transite Bend		4.09		
	1 6" Duplex Adapter		1.62		
	1 hr. Town Shovel @6.50		6.50		
	1 hr. Trucking @3.00		3.00		
			125.12		
				<i>Bill sent 25.12</i>	

TOWN OF LEXINGTON — BOARD OF PUBLIC WORKS

SEWER DIVISION

DATE \_\_\_\_\_

Sketch of Service Here

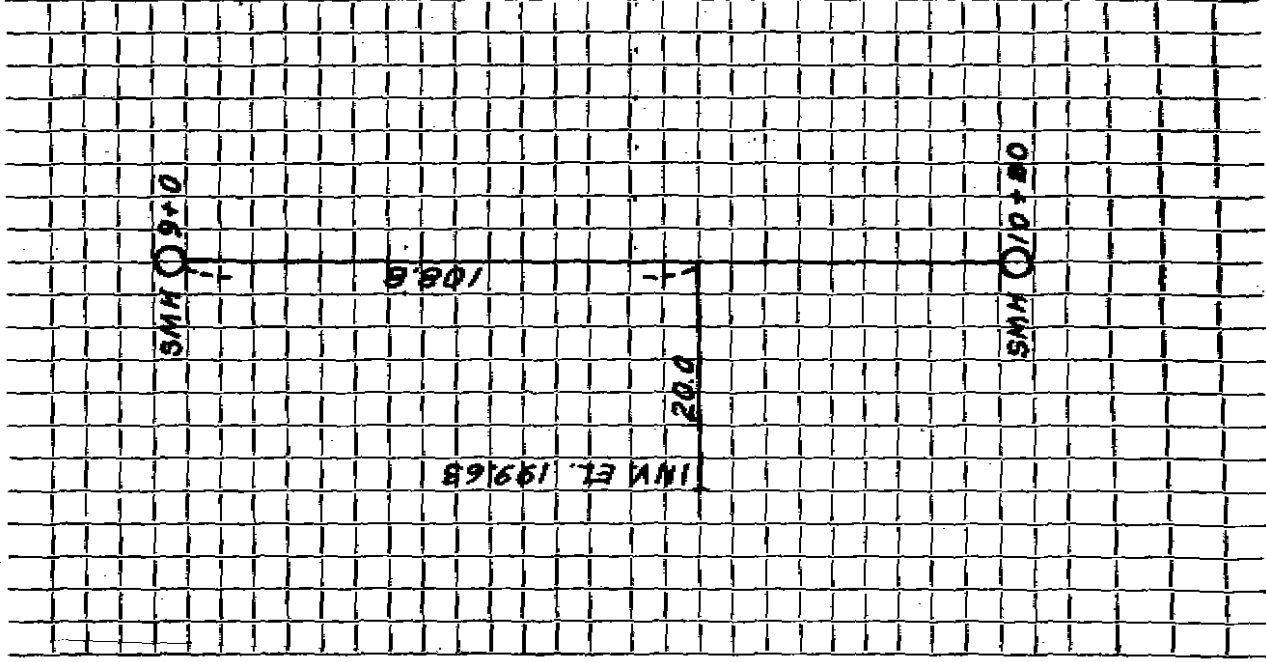

Connection made in \_\_\_\_\_

Street \_\_\_\_\_

Work completed \_\_\_\_\_

Remarks: \_\_\_\_\_  
\_\_\_\_\_  
\_\_\_\_\_